

LINCOLN
G 352
7/31/79

**MISSISSIPPI  
BOARD OF WATER COMMISSIONERS**  
416 North State Street  
Jackson, Mississippi 39201

**WATER WELL DRILLERS LOG**

July 31 19 79 Grenn Water Well Cont. Lincoln  
 date well completed firm name county well located

LANDOWNER: Dennis McCullough  
 Rt. 3, Box 279  
 Brookhaven, Miss.  
 (mailing address)

description of formations encountered	from	to
Citronelle	1	125

**WELL LOCATION:**  
 sec. 1 T. 7 N. R. 7 E  
 S W  
 1/2 miles NE of Brookhaven  
 (distance) (direction) (nearest town)

**WELL PURPOSE:** home  
 (home, irrigation, municipal, industrial)

- WELL COMPLETION DATA:**
- (1) diameter (inches) 4
  - (2) total depth (feet) 125
  - (3) static water level (feet) 45 below top of ground.
  - (4) casing PVC, 113' (material), (depth)  
 4" (size) if telescope see back.
  - (5) screen 10' 113 (length), (depth to top)  
 .010 PVC (size) (material)
  - (6) pump did not install (HP) (yield gpm)
  - (type power)
  - (7) electric log no (yes or no)
  - (organization running log)
  - (8) how well bottom plugged back wash valve

**DRILLERS REMARKS:**


Miss. Board of Water Comm.

AUG 16 1979

**RECEIVED**

If well telescopes please sketch and show depths.

GROUND LEVEL

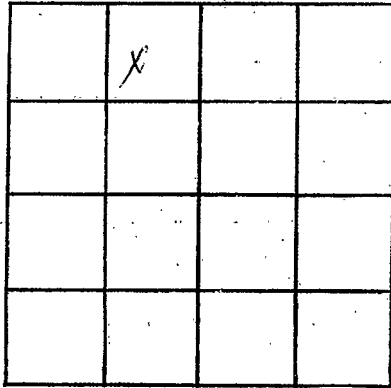

SECTION 1

Please indicate well location X.

ADDITIONAL INFORMATION

If more than one screen, show locations of each on sketch.