

LINCOLN
G 353
7/06/79

**MISSISSIPPI  
BOARD OF WATER COMMISSIONERS**  
416 North State Street  
Jackson, Mississippi 39201

**WATER WELL DRILLERS LOG**

July 6 19 79 Grenn Water Well Cont. Lincoln  
 date well completed firm name county well located

**LANDOWNER:** Odell Briggs  
 Route 2, Box 13  
 Brookhaven, Miss.  
 (mailing address)

description of fomations encountered	from	to
Citronelle	1	97

**WELL LOCATION:**  
 sec. 30 T. 7 N R. 7 E  
 S W  
 4 miles SW of Brookhaven  
 (distance) (direction) (nearest town)

**WELL PURPOSE:** home  
 (home, irrigation, municipal, industrial)

**WELL COMPLETION DATA:**

(1) diameter (inches) 4

(2) total depth (feet) 97

(3) static water level (feet) 65 below ~~above~~ top of ground.

(4) casing PVC 85  
 (material) (depth)  
 4" if telescope see back.  
 (size)

(5) screen 12' 85'  
 (length) (depth to top)  
 .010 PVC  
 (size) (material)

(6) pump did not install  
 (HP) (yield gpm)

(type power)

(7) electric log no  
 (yes or no)

(organization running log)

(8) how well bottom plugged  
 back wash valve

**DRILLERS REMARKS:**


Miss. Board of Water Commr.

AUG 16 1979

**RECEIVED**

If well telescopes please sketch and show depths.

GROUND LEVEL

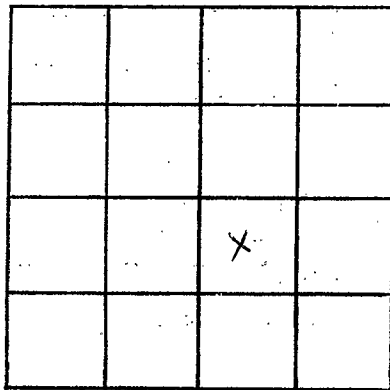

SECTION 30

Please indicate well location X.

ADDITIONAL INFORMATION

If more than one screen, show locations of each on sketch.