

Lincoln  
 G 354  
 6-10-79

MISSISSIPPI  
 BOARD OF WATER COMMISSIONERS  
 416 North State Street  
 Jackson, Mississippi 39201

WATER WELL DRILLERS LOG


June 10 1979 Grenn Water Well Cont. Lincoln  
 date well completed firm name county well located

LANDOWNER: Kenneth Smith	description of formations encountered	from	to
Route 3, Box 76	Citronelle	1	89
Brookhaven, Miss. (mailing address)			
<b>WELL LOCATION:</b>			
sec. 5 T. 7 <sup>N</sup> S R. 7 <sup>E</sup> W			
3 miles NW of Brookhaven (distance) (direction) (nearest town)			
<b>WELL PURPOSE:</b> home (home, irrigation, municipal, industrial)			
<b>WELL COMPLETION DATA:</b>			
(1) diameter (inches) 4			
(2) total depth (feet) 89			
(3) static water level (feet) 60 below top of ground. above.			
(4) casing PVC 77 (material) (depth) 4" (size) if telescope see back.			
(5) screen 12' 77' (length) (depth to top) .010 PVC (size) (material)			
(6) pump 1/2 sub 7 1/2 (HP) (yield gpm) electricity (type power)			
(7) electric log no (yes or no) (organization running log)			
(8) how well bottom plugged back wash valve			
<b>DRILLERS REMARKS:</b>			

*rec'd 9-27-79  
 SW*

If well telescopes please sketch and show depths.

GROUND LEVEL

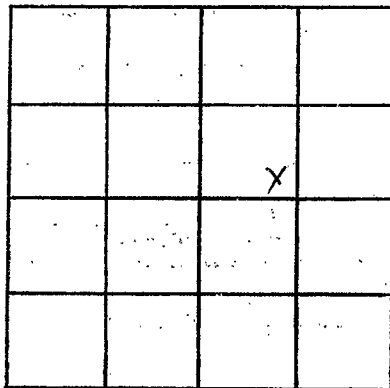

SECTION 5

Please indicate well location X.

ADDITIONAL INFORMATION

If more than one screen, show locations of each on sketch.