

LINCOLN
G 355
04-18-79

**MISSISSIPPI  
BOARD OF WATER COMMISSIONERS**  
416 North State Street  
Jackson, Mississippi 39201

**WATER WELL DRILLERS LOG**

April 18 19 79 Green Water Well Lincoln  
 date well completed firm name county well located

LANDOWNER: Leon Cole  
N. Church St.  
Brookhaven, Ms. 39601  
 (mailing address)

description of formations encountered	from	to
<u>Citronelle</u>	<u>1</u>	<u>72</u>

WELL LOCATION:  
 sec. 34 T 7 N d 7 R 7 E  
 S W  
2 miles SW of Brookhaven  
 (distance) (direction) (nearest town)

WELL PURPOSE: home  
 (home, irrigation, municipal, industrial)

WELL COMPLETION DATA:

(1) diameter (inches) 4"

(2) total depth (feet) 72'

(3) static water level (feet) 45' below above  
 top of ground.

(4) casing PVC 60'  
 (material) (depth)  
4"  
 (size) if telescope see back.

(5) screen 12' 60'  
 (length) (depth to top)  
.010 PVC  
 (size) (material)

(6) pump 1/2 Sub 10  
 (HP) (yield gpm)  
electricity  
 (type power)

(7) electric log no  
 (yes or no)  
 (organization running log)


(8) how well bottom plugged back wash valve

DRILLERS REMARKS:

Miss. Board of Water Comm.  
 MAY 9 1979  
 RECEIVED  
 MISSISSIPPI

If well telescopes please sketch and show depths.

GROUND LEVEL

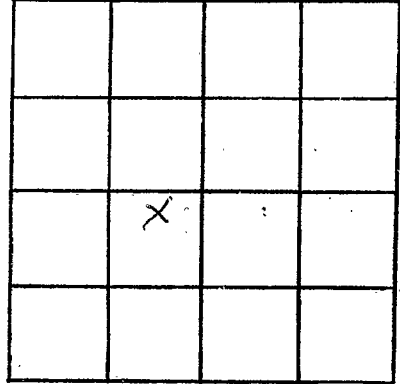

SECTION 34

Please indicate well location X.

ADDITIONAL INFORMATION

If more than one screen,  
show locations of each on sketch.