

LINCOLN
G 357
1-05-79

**MISSISSIPPI
BOARD OF WATER COMMISSIONERS**
416 North State Street
Jackson, Mississippi 39201

WATER WELL DRILLERS LOG

Jan. 5 19 79 Grenn Water Well Cont. Lincoln
 date well completed firm name county well located

LANDOWNER:	description of fomations encountered	from	to
John Earl Washington Route 2, Box 89 Brookhaven, Miss. 39601	Citronelle	1	146
(mailing address)			
WELL LOCATION:			
sec. 18 T. 7 N R. 7 E S W			
7 miles W of Brookhaven (distance) (direction) (nearest town)			
WELL PURPOSE: home (home, irrigation, municipal, industrial)			
WELL COMPLETION DATA:			
(1) diameter (inches) 4			
(2) total depth (feet) 146			
(3) static water level (feet) 65 below top of ground. above			
(4) casing PVC 134 (material) (depth)			
4" if telescope see back. (size)			
(5) screen 12' 134' (length) (depth to top)			
.010 PVC (size) (material)			
(6) pump did not install (HP) (yield gpm)			
(type power)			
(7) electric log no (yes or no)			
(organization running log)			
(8) how well bottom plugged back wash valve			
DRILLERS REMARKS:			


Miss. Board of Water Comm.

FEB 14 1979

RECEIVED

If well telescopes please sketch and show depths.

GROUND LEVEL

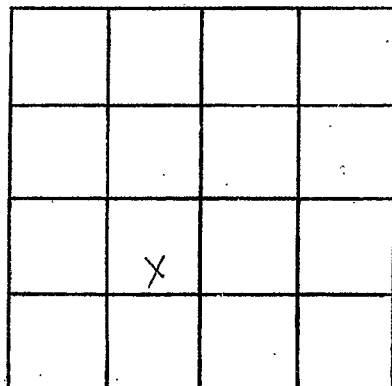

SECTION 18

Please indicate well location X.

ADDITIONAL INFORMATION

If more than one screen, show locations of each on sketch.