

Lincoln
 5 363
 8/26/77

MISSISSIPPI
 BOARD OF WATER COMMISSIONERS
 416 North State Street
 Jackson, Mississippi 39201

WATER WELL DRILLERS LOG

Aug. 26 77, Brookfield Well Serv. Lincoln
 date well completed firm name county well located

LANDOWNER: Calico
 Brookhaven Miss
 (mailing address)

WELL LOCATION:
 sec. 20 T. 7 N R. 7 E
 6 miles W of B. Haven
 (distance) (direction) (nearest town)

WELL PURPOSE: Farm
 (home, irrigation, municipal, industrial)

- WELL COMPLETION DATA:
- (1) diameter (inches) 4
 - (2) total depth (feet) 174
 - (3) static water level (feet) 90 below top of ground.
 - (4) casing Plastic, 160 (material) (depth)
 - 4 (size) If telescope see back.
 - (5) screen 10 160 (length) (depth to top)
 - 4 Plastic (size) (material)
 - (6) pump 1/2 8 (HP) (yield gpm)
 - (type power)
 - (7) electric log (yes or no)
 - (organization running log)
 - (8) how well bottom plugged Wood

description of formations encountered	from	to
CIAU	0	18
CIAU + SAND	18	44
CLAY	44	60
SAND	60	70
SAND + BRCK	70	82
CLAY	82	118
SAND	118	160
SAND + BRCK	160	174
SALT WATER		
60 to 81		
Set PACKER		
90' Pumped 5		
Bags Cement		
Around casing		
Sealed bet well		
water lines		


RECEIVED
 NOV - 2 1977

MISS. BD OF WATER COMMISSIONERS

DRILLERS REMARKS:

If well telescopes please sketch and show depths.

GROUND LEVEL

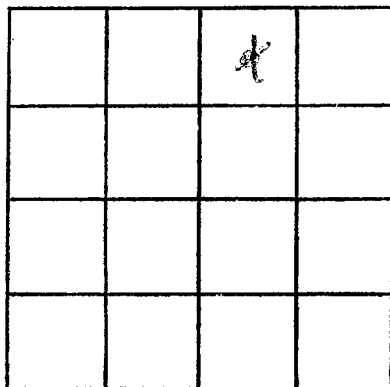

SECTION 23

Please indicate well location X.

ADDITIONAL INFORMATION

If more than one screen, show locations of each on sketch.