

Lincoln  
G 364  
8/23/77

MISSISSIPPI  
 BOARD OF WATER COMMISSIONERS  
 416 North State Street  
 134 Jackson, Mississippi 39201

WATER WELL DRILLERS LOG

Aug. 23 1977 Grenn Water Well Contractor Lincoln  
 date well completed firm name county well located

LANDOWNER: Mrs. Allie Smith  
Route 2, Box 9  
Brookhaven, Miss.  
 (mailing address)

description of formations encountered	from	to
<u>Citronelle</u>	<u>1</u>	<u>76</u>

WELL LOCATION:  
 sec. 29 T. 7 S. R. 7 E.  
3 miles SW Brookhaven  
 (distance) (direction) (nearest town)

WELL PURPOSE: Home  
 (home, irrigation, municipal, industrial)

WELL COMPLETION DATA:

(1) diameter (inches) 6

(2) total depth (feet) 76

(3) static water level (feet) 45 below above top of ground.

(4) casing PVC 70'  
 (material) (depth)  
4" if telescope see back.  
 (size)

(5) screen 6' 70'  
 (length) (depth to top)  
.010 PVC  
 (size) (material)

(6) pump did not install  
 (HP) (yield gpm)

(type power)

(7) electric log no  
 (yes or no)

(organization running log)

(8) how well bottom plugged back wash valve

DRILLERS REMARKS:


**RECEIVED**

OCT 26 1977

MISS. BD. OF WATER COMM

If well telescopes please sketch and show depths.

GROUND LEVEL

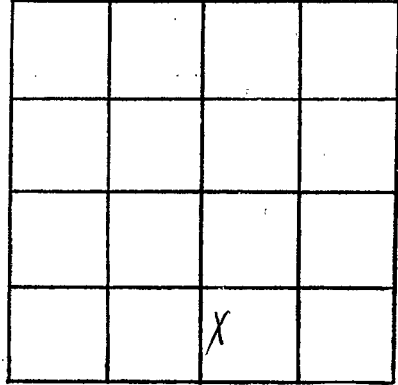

SECTION 29

Please indicate well location X.

ADDITIONAL INFORMATION

If more than one screen,  
show locations of each on sketch.