

Lincoln  
G 366  
7-20-77

MISSISSIPPI  
 BOARD OF WATER COMMISSIONERS  
 416 North State Street  
 134 Jackson, Mississippi 39201

WATER WELL DRILLERS LOG

July 20 1977 Grenn Water Well Cont. Lincoln  
 date well completed firm name county well located

LANDOWNER: Lester Reed  
Route 1, Box 175  
Bogue Chitto, Miss.  
 (mailing address)

description of fomations encountered	from	to
<u>citonelle</u>	<u>1</u>	<u>132</u>

WELL LOCATION:  
 sec: 8 T: 7 N R: 7 E  
3 miles W of Brookhaven  
 (distance) (direction) (nearest town)

WELL PURPOSE: home  
 (home, irrigation, municipal, industrial)

WELL COMPLETION DATA:

- (1) diameter (inches) 6
  - (2) total depth (feet) 132
  - (3) static water level (feet) 70 below top of ground.
  - (4) casing PVC, 120  
 (material) (depth)  
4"  
 (size) If telescope see back.
  - (5) screen 12' 120'  
 (length) (depth to top)  
.010 PVC  
 (size) (material)
  - (6) pump 1/2 hp sub 10  
 (HP) (yield gpm)  
electricity  
 (type power)
  - (7) electric log XXXXX no  
 (yes or no)
- (organization running log)

(8) how well bottom plugged  
back wash valve


DRILLERS REMARKS:

RECEIVED  
 AUG 24 1977

MISSISSIPPI BOARD OF WATER COMMISSIONERS

If well telescopes please sketch and show depths.

GROUND LEVEL

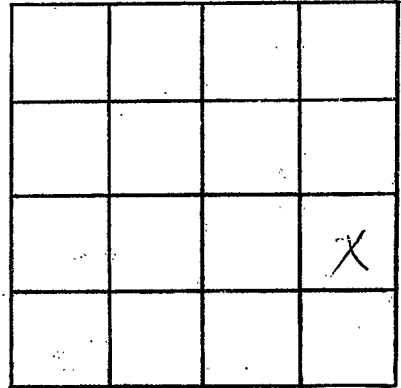

SECTION 8

Please indicate well location X.

ADDITIONAL INFORMATION

If more than one screen,  
show locations of each on sketch.