

Lincoln  
G 367  
June 8, 1977

MISSISSIPPI  
 BOARD OF WATER COMMISSIONERS  
 416 North State Street  
 Jackson, Mississippi 39201

WATER WELL DRILLERS LOG

June 8 1977 Grenn Water Well Cont. Lincoln  
 date well completed firm name county well located

LANDOWNER: Coleman Lea  
Route 2, Brookhaven  
 (mailing address)

description of formations encountered	from	to
<u>Citronelle</u>	<u>1</u>	<u>109</u>

WELL LOCATION:  
 sec. 1 T. 7 N R. 7 E  
 S W  
1 miles NW of Brookhaven  
 (distance) (direction) (nearest town)

WELL PURPOSE: home  
 (home, irrigation, municipal, industrial)

- WELL COMPLETION DATA:
- (1) diameter (inches) 6
  - (2) total depth (feet) 109
  - (3) static water level (feet) 35 below  
 top of ground. above
  - (4) casing PVC, 97  
 (material) (depth)  
4"  
 (size) If telescope see back.
  - (5) screen 12', 97'  
 (length) (depth to top)  
.010 PVC  
 (size) (material)
  - (6) pump 1/2 HP sub. 10  
 (HP) (yield gpm)  
electricity  
 (type power)
  - (7) electric log no  
 (yes or no)
- (organization running log)
- (8) how well bottom plugged  
back wash valve


**RECEIVED**  
 AUG 24 1977

DRILLERS REMARKS:

MISS. Bd. OF WATER COMMISSIONERS

If well telescopes please sketch and show depths.

GROUND LEVEL

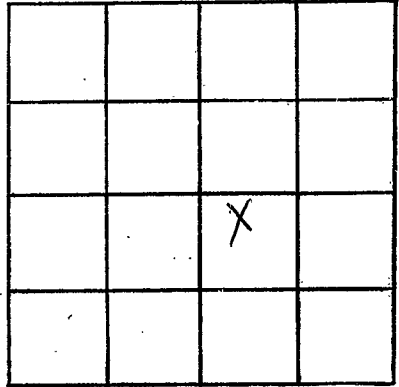

SECTION 1

Please indicate well location X.

ADDITIONAL INFORMATION

If more than one screen,  
show locations of each on sketch.