

MISSISSIPPI  
 BOARD OF WATER COMMISSIONERS  
 416 North State Street  
 Jackson, Mississippi 39201

WATER WELL DRILLERS LOG

Lincoln  
G 371  
4/26/77

April 26 1977 Grenn Water Well Cont. Lincoln  
 date well completed firm name county well located


LANDOWNER:	description of formations encountered	from	to
Troy Furr Brookhaven, Miss. (mailing address)			
<b>WELL LOCATION:</b>			
sec <u>33</u> T <u>7</u> N R <u>7</u> E <small>(distance) (direction) (nearest town)</small>			
<u>2</u> miles <u>SW</u> of <u>Brookhaven</u> <small>(distance) (direction) (nearest town)</small>			
<b>WELL PURPOSE:</b> <u>home</u> <small>(home, irrigation, municipal, industrial)</small>			
<b>WELL COMPLETION DATA:</b>			
(1) diameter (inches) <u>6</u>			
(2) total depth (feet) <u>43</u>			
(3) static water level (feet) <u>28</u> below top of ground. <small>(above)</small>			
(4) casing <u>PVC</u> <u>31</u> <small>(material) (depth)</small> <u>4"</u> if telescope see back. <small>(size)</small>			
(5) screen <u>12'</u> <u>31'</u> <small>(length) (depth to top)</small> <u>.010</u> <u>pvc</u> <small>(size) (material)</small>			
(6) pump <u>did not install</u> <small>(HP) (yield gpm)</small> <small>(type power)</small>			
(7) electric log <u>no</u> <small>(yes or no)</small> <small>(organization running log)</small>			
(8) how well bottom plugged <u>back wash valve</u>			
DRILLERS REMARKS:			

**RECEIVED**  
 JUN 14 1977

MISSISSIPPI BOARD OF WATER COMMISSIONERS

If well telescopes please sketch and show depths.

GROUND LEVEL

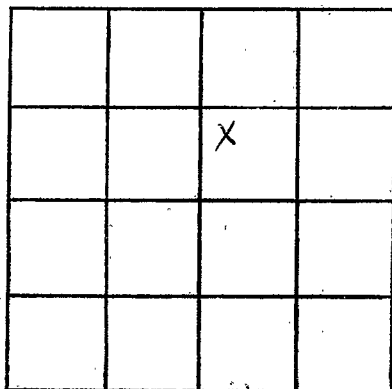

SECTION 33

Please indicate well location X.

ADDITIONAL INFORMATION

If more than one screen,  
show locations of each on sketch.