

Lincoln
 G 372
 4-16-77

MISSISSIPPI
 BOARD OF WATER COMMISSIONERS
 416 North State Street
 1324 Jackson, Mississippi 39201

WATER WELL DRILLERS LOG

4-16-77 19 Grenn Water Well Cont. Lincoln
 date well completed firm name county well located

LANDOWNER: Chester Foster
 408 E. Cherokee
 Brookhaven, Miss.
 (mailing address)

description of fomations encountered	from	to
Citronelle	1	77

WELL LOCATION:
 sec. 34 T 7 N R 7 E
2 miles SW of Brookhaven
 (distance) (direction) (nearest town)

WELL PURPOSE: home
 (home, irrigation, municipal, industrial)

- WELL COMPLETION DATA:
- (1) diameter (inches) 6
 - (2) total depth (feet) 77
 - (3) static water level (feet) 50 below top of ground.
 - (4) casing PVC 65
 (material) (depth)
4" if telescope see back.
 (size)
 - (5) screen 12' 65'
 (length) (depth to top)
.010 PVC
 (size) (material)
 - (6) pump 3/4 sub 10
 (HP) (yield gpm)
electricity
 (type power)
 - (7) electric log no
 (yes or no)
- (organization running log)

(8) how well bottom plugged
back wash valve


DRILLERS REMARKS:

RECEIVED
 APR 22 1977

MISS. BD. OF WATER COMMISSIONERS

If well telescopes please sketch and show depths.

GROUND LEVEL

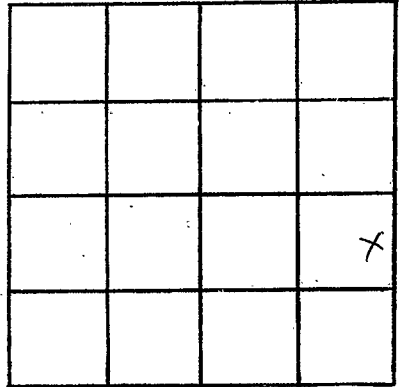

SECTION 34

Please indicate well location X.

ADDITIONAL INFORMATION

If more than one screen, show locations of each on sketch.