

Lincoln  
G 373  
2-16-77

MISSISSIPPI  
 BOARD OF WATER COMMISSIONERS  
 416 North State Street  
 Jackson, Mississippi 39201

WATER WELL DRILLERS LOG


16 Feb <sup>134</sup> 1977 J.T. Conroy & Co Lincoln  
 date well completed firm name county well located

LANDOWNER:	description of formations encountered	from	to
<u>John Bonehill</u> <u>Brookhaven</u> (mailing address)	<u>clay</u> <u>3rd clay</u> <u>iron</u>	<u>0</u> <u>20</u> <u>40</u>	<u>20</u> <u>40</u> <u>68</u>
<b>WELL LOCATION: ?</b> sec. <u>31</u> T. <u>07</u> N. R. <u>7</u> E <u>5</u> miles <u>S</u> of <u>Brookhaven</u> (distance) (direction) (nearest town)			
<b>WELL PURPOSE:</b> (home, irrigation, municipal, industrial)			
<b>WELL COMPLETION DATA:</b>			
(1) diameter (inches) <u>4</u>			
(2) total depth (feet) <u>68</u>			
(3) static water level (feet) <u>50</u> below above top of ground.			
(4) casing <u>11</u> <u>62</u> (material) (depth)			
(size) If telescope see back.			
(5) screen <u>6</u> <u>62</u> (length) (depth to top)			
(size) (material)			
(6) pump <u>1/2</u> <u>8</u> (HP) (yield gpm)			
<u>alt</u> (type power)			
(7) electric log _____ (yes or no)			
(organization running log)			
(8) how well bottom plugged <u>wood</u>			
DRILLERS REMARKS:			

**RECEIVED**  
 APR 4 1977

If well telescopes please sketch and show depths.

GROUND LEVEL

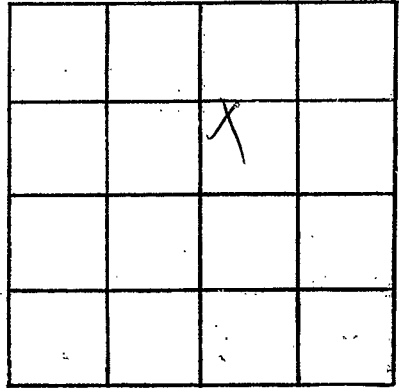

SECTION 31

Please indicate well location X.

ADDITIONAL INFORMATION

If more than one screen, show locations of each on sketch.