

Lincoln
G 374
11/2/76

MISSISSIPPI
BOARD OF WATER COMMISSIONERS
416 North State Street
Jackson, Mississippi 39201

WATER WELL DRILLERS LOG

Nov. 2
date well completed

1326

1976 Peewee Well Sec.
firm name

Lincoln
county well located

LANDOWNER:	description of formations encountered	from	to
Glen Hurst P.O. box Brookman (mailing address)			
WELL LOCATION:			
sec. 15 T 7 N R 7 E			
1 miles west of Brookman (distance) (direction) (nearest town)			
WELL PURPOSE: new house (home, irrigation, municipal, industrial)			
WELL COMPLETION DATA:			
(1) diameter (inches) 4"			
(2) total depth (feet) 76			
(3) static water level (feet) 45 below above top of ground.			
(4) casing plastic bottom (material) (depth)			
_____ If telescope see back. (size)			
(5) screen 6" 70' (length) (depth to top)			
4" plastic (size) (material)			
(6) pump 1/2 Sub 10 (HP) (yield gpm)			
electric (type power)			
(7) electric log no (yes or no)			
_____ (organization running log)			
(8) how well bottom plugged washed plug			
DRILLERS REMARKS: well inside house (new exposure)			


RECEIVED

FEB - 4 1977

MISS. BD. OF WATER COMMISSIONERS

If well telescopes please sketch and show depths.

GROUND LEVEL

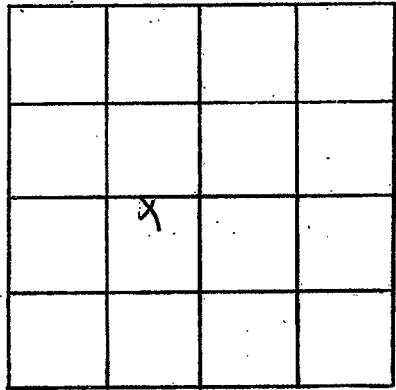

SECTION 15

Please indicate well location X.

ADDITIONAL INFORMATION

If more than one screen, show locations of each on sketch.