

**MISSISSIPPI
BOARD OF WATER COMMISSIONERS**
416 North State Street
Jackson, Mississippi 39201

WATER WELL DRILLERS LOG

Lincoln
G 375
9-22-76

134

9-22
date well completed

1976 Glenn Water Wells
firm name

Lincoln
county well located

LANDOWNER:	description of formations encountered	from	to
<i>Ralph Banks</i>	<i>Citronella</i>	<i>1</i>	<i>47</i>
<i>Brookhaven, Miss</i> <i>Rt 2 (mailing address)</i>			
WELL LOCATION:			
<p>sec. <i>15</i> T. <i>7</i> N R. <i>7</i> E <i>1</i> miles <i>W</i> of <i>Brookhaven</i> (distance) (direction) (nearest town)</p>			
WELL PURPOSE: <i>home</i> (home, irrigation, municipal, industrial)			
WELL COMPLETION DATA:			
(1) diameter (inches) <i>6"</i>			
(2) total depth (feet) <i>47</i>			
(3) static water level (feet) <i>34</i> below top of ground.			
(4) casing <i>PVC</i> <i>35'</i> (material) (depth)			
<i>4"</i> if telescope see back. (size)			
(5) screen <i>12'</i> <i>35'</i> (length) (depth to top)			
<i>0.10</i> <i>PVC</i> (size) (material)			
(6) pump <i>did not install</i> (HP) (yield gpm)			
(type power)			
(7) electric log <i>no</i> (yes or no)			
(organization running log)			
(8) how well bottom plugged <i>Back wash valve</i>			
DRILLERS REMARKS:			


RECEIVED

NOV - 8 1976

MISS. BD. OF WATER COMM.

If well telescopes please sketch and show depths.

GROUND LEVEL

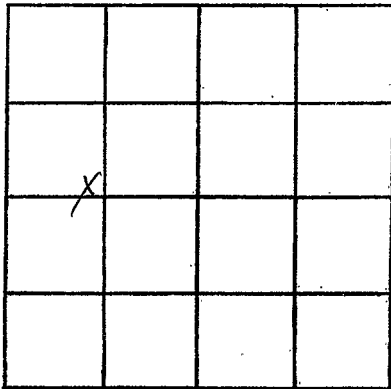

SECTION 15

Please indicate well location X.

ADDITIONAL INFORMATION

If more than one screen,
show locations of each on sketch.