

Lincoln
G 376
6-9-76

MISSISSIPPI
 BOARD OF WATER COMMISSIONERS
 416 North State Street
 134 Jackson, Mississippi 39201

WATER WELL DRILLERS LOG

June 9 1976 Grann Water Well Cont. Lincoln
 date well completed firm name county well located


LANDOWNER: Roger Smith	description of formations encountered	from	to
Rt. 5, Box 233 Brookhaven, Miss. (mailing address)			
WELL LOCATION:			
sec. 27 T. 7 N. R. 7 E S W (distance) (direction) (nearest town)			
WELL PURPOSE: home (home, irrigation, municipal, industrial)			
WELL COMPLETION DATA:			
(1) diameter (inches) 4			
(2) total depth (feet) 50			
(3) static water level (feet) 30 below top of ground.			
(4) casing PVC, 38 (material), (depth) 4" (size) if telescope see back.			
(5) screen 12' (length), 38 (depth to top) .010 PVC (size) (material)			
(6) pump did not install (HP) (yield gpm)			
(7) electric log no (yes or no)			
(8) how well bottom plugged: Basket Wash valve			
DRILLERS REMARKS:			

RECEIVED

AUG 9 - 1976

If well telescopes please sketch and show depths.

GROUND LEVEL

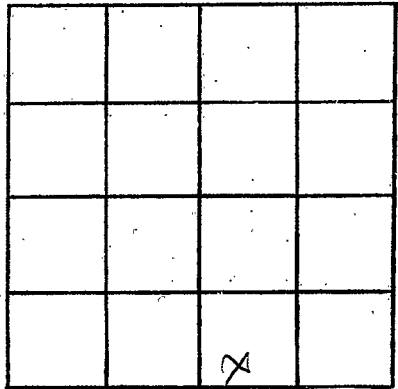

SECTION 27

Please indicate well location X.

ADDITIONAL INFORMATION

If more than one screen, show locations of each on sketch.