

Lincoln
G 377
10-16-75

MISSISSIPPI
 BOARD OF WATER COMMISSIONERS
 416 North State Street
 Jackson, Mississippi 39201


WATER WELL DRILLERS LOG

Oct. 16 19 75 Grenn Water Well Cont. Lincoln
 date well completed firm name county well located

LANDOWNER: <u>Ed. Lambright</u>	description of fomations encountered	from	to
Route 2, Box 245 Brookhaven, Miss. (mailing address)			
	Clay	1	18
	Sand & Gravell	18	57
	White clay	57	90
	gray clay	90	100
	sand	100	110
	clay	110	113
	fine sand	113	150
	sand & gravel	150	160
WELL LOCATION: sec <u>21</u> T <u>7</u> <u>N</u> R <u>7</u> <u>E</u> ^{13u} 2 miles W of Brookhaven (distance) (direction) (nearest town)			
WELL PURPOSE: <u>home</u> (home, irrigation, municipal, industrial)			
WELL COMPLETION DATA:			
(1) diameter (inches) <u>6</u>			
(2) total depth (feet) <u>160</u>			
(3) static water level (feet) <u>45</u> below/above top of ground.			
(4) casing <u>PVC</u> <u>154</u> (material) (depth) <u>4"</u> (size) if telescope see back.			
(5) screen <u>6'</u> <u>154'</u> (length) (depth to top) <u>.010</u> <u>PVC</u> (size) (material)			
(6) pump <u>1/3</u> sub <u>7</u> (HP) (yield gpm) <u>electric</u> (type power)			
(7) electric log <u>no</u> (yes or no) (organization running log)			
(8) how well bottom plugged <u>wood</u>			
DRILLERS REMARKS: <div style="text-align: right; opacity: 0.5;"> RECEIVED OCT 27 1975 MISS. Bd. OF WATER COMMISSIONERS </div>			

If well telescopes please sketch and show depths.

GROUND LEVEL

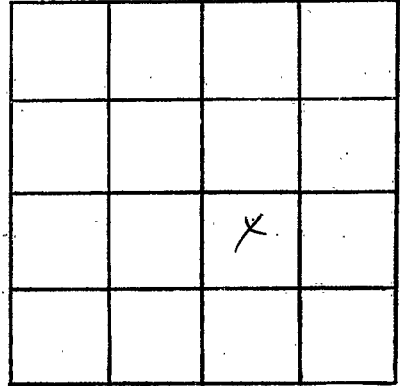

SECTION 21

Please indicate well location X.

ADDITIONAL INFORMATION

If more than one screen, show locations of each on sketch.