


Lincoln
G 37B
3/5/76

MISSISSIPPI
BOARD OF WATER COMMISSIONERS
416 North State Street
134 Jackson, Mississippi 39201

WATER WELL DRILLERS LOG

Mar. 5 1976 Grenn Water Well Con Lincoln
date well completed firm name county well located

LANDOWNER:	description of formations encountered	from	to
Brookhaven Academy			
	sand & gravel	20	40
	White clay	40	63
(mailing address)	blue clay	63	85
WELL LOCATION:	sand	85	95
sec. 22 T. 7 S. R. 7 E	clay	95	99
1 miles W of Brookhaven	sand	99	153
(distance) (direction) (nearest town)			
WELL PURPOSE: school			
(home, irrigation, municipal, industrial)			
WELL COMPLETION DATA:			
(1) diameter (inches) 4			
(2) total depth (feet) 153			
(3) static water level (feet) 40 below top of ground			
(4) casing PVC 141 (material) (depth)			
4" (size) If telescope see back.			
(5) screen 12' 141' (length) (depth to top)			
.010 PVC (size) (material)			
(6) pump did not install (HP) (yield gpm)			
(type power)			
(7) electric log no (yes or no)			
(organization running log)			
(8) how well bottom plugged wood			
DRILLERS REMARKS:			

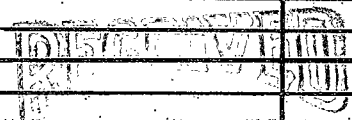

MAY 27 1976

