

MISSISSIPPI DEPARTMENT OF ENVIRONMENTAL QUALITY

Office of Land and Water Resources

P. O. Box 10631
Jackson, MS 39289-0631

WATER WELL DRILLERS LOG

COUNTY WELL LOCATED
Lincoln

WELL NUMBER G-432 CODED

DATE WELL COMPLETED
3/10/03

PERMIT NUMBER

NAME OF DRILLING FIRM
Green Water Well & Supply, Inc.

NAME & MAILING ADDRESS OF LANDOWNER
Harold King
709 Hwy 84 W, Brookhaven

Latitude:
Longitude:

WELL LOCATION: SEC 32 TOWNSHIP 7 N RANGE 7 E
S W

DISTANCE 4 Miles DIRECTION SW of NEAREST TOWN Brookhaven

OTHER LANDMARK

WELL PURPOSE: Home, Irrigation, Municipal, Industrial, Fish Pond, etc.

PUMP DATA

PUMP TYPE (Circle One):
 Submersible Turbine, Jet, Flowing Well,
Other (Describe) _____

POWER TYPE (Circle One):
 Electric, Tractor, Diesel, Gasoline, Butane,
Other (Describe) _____ H/P 5

DESCRIPTION OF FORMATIONS ENCOUNTERED	FROM	TO
<u>red clay</u>	<u>0</u>	<u>17</u>
<u>sand</u>	<u>17</u>	<u>35</u>
<u>sand + gravel</u> <u>red clay</u>	<u>35</u>	<u>42</u>
<u>sand + gravel</u>	<u>42</u>	<u>84</u>
<u>white clay</u>	<u>84</u>	<u>90</u>

WELL DATA

Well Depth <u>84'</u>	Casing Diameter (In.) <u>4</u>	Casing Length (Ft.) <u>74</u>
Type of Casing <u>PVC</u>	Hole Depth <u>90'</u>	Depth to Static Water Level <u>50'</u>

TYPE OF COMPLETION: (Circle One or More):
 Gravel Packed, Underreamed, Telescoped,
 Natural Development, Open Hole, Other
(Describe) _____

WELL GROUTED TO A DEPTH OF 10 FEET
Type Grout (circle one): Cement, Bentonite, or Mix

SCREEN DATA

Diameter - Inches <u>4</u>	Length - Feet <u>10</u>	Slot Size - Inches <u>.010</u>
Screen Type <u>PVC</u>	Depth to Bottom - Feet <u>84</u>	

RECEIVED

APR 08 2003

BY: OLWIR

Top of Lap Pipe or Reduction in Casing

FEET IF TELESCOPED OR MORE THAN ONE SCREEN: USE BACK PAGE

I certify that the well was drilled, constructed and completed in accordance with all applicable Requirements of the Mississippi Department of Environmental Quality and/or the Mississippi Department of Health regulations and state laws.


Brian McClendon 664
Signature of Licensed Driller and License No.

3/10/03
Date

Additional Information Required On Back

If well telescopes please sketch and show depths.

GROUND LEVEL

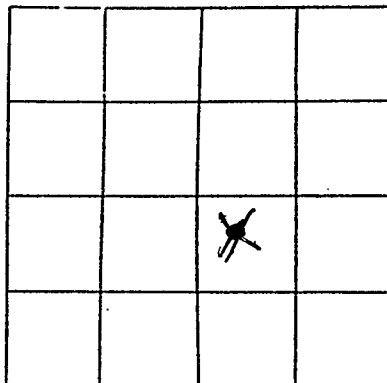

SECTION 32

Please indicate well location X.

Pump Capacity (GPM)	No. of Stages	Setting Depth
<u>10</u>	<u>9</u>	<u>80</u> FT.

PUMP TEST

Well yielded 12 GPM with
 a drawdown of 2 ft.
 after 1 hours of pumping

LOG DATA

TYPE OF LOG RUN (Circle One): No Log Run
 Electric, Gamma Ray, Density, Sonic, Neutron,
 Other (Describe) _____

Name of Organization Running Log _____

GEOLOGIC DATA (Office Use Only)

Surface Elev.	Geologic Unit	Unit Thickness	Depth to Top
Subs. SWL	Date	Analysis	Aquifer Test

Driller's Remarks

If more than one screen,
 show location of each on sketch.