

MISSISSIPPI DEPARTMENT OF ENVIRONMENTAL QUALITY

Office of Land and Water Resources

P. O. Box 10631  
Jackson, MS 39289-0631  
WATER WELL DRILLERS LOG

COUNTY WELL LOCATED  
Lincoln

WELL NUMBER B-460 CODED

DATE WELL COMPLETED  
7/1/04

PERMIT NUMBER

NAME OF DRILLING FIRM  
Green Water Well & Supply, Inc.

NAME & MAILING ADDRESS OF LANDOWNER  
Clayton Hedges

22 Shady Creek Tr., Brookhaven

Latitude:  
Longitude:

WELL LOCATION: SEC 26 TOWNSHIP 7<sup>N</sup><sub>S</sub> RANGE 7<sup>E</sup><sub>W</sub>

DISTANCE 1 Miles DIRECTION S NEAREST TOWN Brookhaven

OTHER LANDMARK

WELL PURPOSE  Home Irrigation, Municipal, Industrial, Fish Pond, etc.

PUMP DATA

PUMP TYPE (Circle One):  
 Submersible Turbine Jet Flowing Well,  
Other (Describe)

POWER TYPE (Circle One):  
 Electric Tractor Diesel Gasoline Butane,  
Other (Describe) H/P 1.5

DESCRIPTION OF FORMATIONS ENCOUNTERED	FROM	TO
<u>clay/gravel</u>	<u>0</u>	<u>22</u>
<u>sand &amp; gravel</u>	<u>22</u>	<u>50</u>
<u>white clay</u>	<u>50</u>	<u>62</u>
<u>blue clay</u>	<u>62</u>	<u>80</u>
<u>streaky</u>	<u>80</u>	<u>92</u>
<u>sand</u>	<u>92</u>	<u>161</u>
<u>blue clay</u>	<u>161</u>	<u>166</u>

RECEIVED  
AUG 04 2004  
BY: OIWR

Top of Lap Pipe or Reduction in Casing  
FEET  IF TELESCOPED OR MORE THAN ONE SCREEN: USE BACK PAGE

WELL DATA

Well Depth <u>160'</u>	Casing Diameter (In.) <u>4</u>	Casing Length (Ft.) <u>140</u>
Type of Casing <u>PVC</u>	Hole Depth <u>166</u>	Depth to Static Water Level <u>35</u>

TYPE OF COMPLETION: (Circle One or More):  
 ~~Cravel Packed~~ Underreamed Telescoped,  
Natural Development Open Hole Other  
(Describe)

WELL GROUTED TO A DEPTH OF 10 FEET  
Type Grout (circle one): Cement,  Bentonite, or

SCREEN DATA

Diameter - Inches <u>4</u>	Length - Feet <u>20</u>	Slot Size - Inches <u>.010</u>
Screen Type <u>PVC</u>	Depth to Bottom - Feet <u>160</u>	

I certify that the well was drilled, constructed and completed in accordance with all applicable Requirements of the Mississippi Department of Environmental Quality and/or the Mississippi Department of Health regulations and state laws.


Brian McClendon 664  
Signature of Licensed Driller and License No.

7/1/04  
Date

Additional Information Required On Back

If well telescopes please sketch and show depths.

GROUND LEVEL

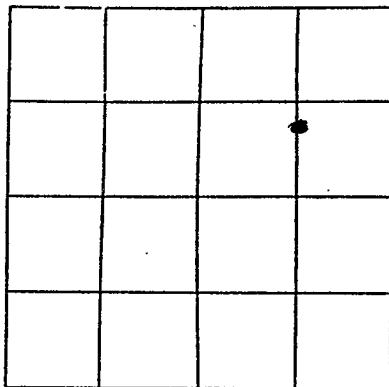

SECTION 26

Please indicate well location X.

Pump Capacity (GPM)	No. of Stages	Setting Depth
25	9	65 FT.

PUMP TEST

Well yielded 28 GPM with  
 a drawdown of 4 ft.  
 after 1 hours of pumping

LOG DATA

TYPE OF LOG RUN (Circle One): No Log Run.  
 Electric, Gamma Ray, Density, Sonic, Neutron,  
 Other (Describe) \_\_\_\_\_

Name of Organization Running Log \_\_\_\_\_

GEOLOGIC DATA (Office Use Only)

Surface Elev.	Geologic Unit	Unit Thickness	Depth to Top
Subs. SWL	Date	Analysis	Aquifer Test

Driller's Remarks

---



---



If more than one screen,  
 show location of each on sketch.