

	State Well Report	
1 mile	Part 1 – Driller's Log	For Office Use Only:
County: Licoln. Mi	ssissippi Department of Environmental Qualit	y Aquifer: 121
Permit #	Office of Land and Water Resources	Well #: 6547
Driller: Fitzurald Wellfero	P.O. Box 2309 Jackson, MS 39225	Well #:
Date drilling completed: 10-4-11.	(601)961- 5210 (601)961- 5228 (fax)	E-log #:
Canto I any negatives that this per out he	menand by the license holder remainly	
	prepared by the license holder responsible j hin 30 days of completion of drilling of the	
Information on Well Owne		r Borehole Location
(Landowner if borehole is not for a	water well)	29.1" Longitude: 90° 32, 10,2"
Owner Name Robert Repey		
Mailing Address: Lower Meadville K	Method of Lat/Long (circ	le one): Conventional Survey,
	USGS quad, Hand-	held GPS, Survey-grade GPS
0 11	NW1/4 N/4 Sec	Twn Left Rng CE 31 7N 7E Nearest Town
Brockhaven ms	SW SE	31 7N 7F
City State	Zip Code Distance Direction	
Telephone No. ()		01
16 19	Well / Borehole Data	
Date drilling started: 0-9-11 Date drilling	completed: 18-4-11 Hole depth: 122-	Hole diameter:
Location of the source of any surface water use	ed for drilling:	
Method of dosing and volume of Chlorine use		
Loss min (airele all annliaghle): the loss m	lectric Gamma Ray Density Sonic Neutron	Other
Name of organization running log(s):	lectric Gamma Ray Density Some Neutro	n Other:
Demos Charles (1 - 1 - 2 - 2 - 2 - 2 - 2 - 2 - 2 - 2 -		
Purpose of borehole (check one): water well	_ Geotechnical/Geological Investigation Gro	bund Source Heat Pump
Seismic Surve	eyOther (describe)	
If drilling is not related to w	ater well construction, skip the remainder of thi	s block
Purpose of Well (check one): HomeIndust	rial Public Supply Irrigation Fish Cult	ure Other:
If a flowing well, method of flow regulation: V	alve Other (describe)	
Static Water Level: <u>64</u> feet above	or below (circle one) land surface Date measur	ed: 10-4-11
Method of Measurement (circle one)	electric tape air line other:	
Well depth: 122 Well grouted to a depth of	f 10 feet Type of grout (circle one): Neat	Cement Bentonite Mix
Casing length:feet Casing dia	ameter: <u>4</u> inches Type of casing	; fre
Screen length:feet Screen did	ameter: <u>4["]</u> inches Type of screen	. Ac
Screen slot size:	etting depth: Fromfeet to	122 feet
Type of completion (circle all applicable):	avel packed Underreamed Telescoped O	pen hole Natural Development
Ot	her (describe):	
Top of lap pipe or reduction in casing:	feet. If telescoped or more than one s	screen, describe on next page

Form: OLWR-SWR-1A (04/08)

RECEIVED OCT 3 1 2011 BY: OLWR

The sketch below only required for water wells

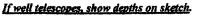

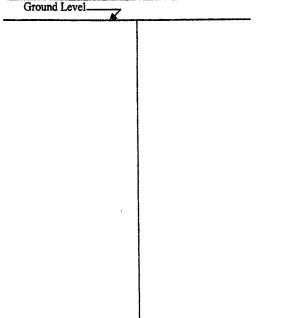

Description of formations encountered must be provided for all wells and boreholes, unless specifically exempted by regulations

Description of Formations Encountered	From (depth) To (depth)	

Description of Formations Diroodition		
	Ground Level	
Clurt		20
Clay/ Saud Clay/ Cast Sand	20 80 100	20 80 100 122
Chin	80	110
Constant Const	100	120
(oute sound	+ 100	1
		<u> </u>
	_ <u>_</u>	
		L
		1
		1
1		+
1		l

If more than one screen, show location of each on sketch

Sketch the property layout and include the following: 1) the wel aid in locating the well; 3) any roads, power lines, 4) a north arrow.	I location; 2) any permanent structures on the property that may or other items that may aid in locating the property and the well;
	Joseph Let
	, and a second s
Huy 84.	
Landowner Name: Kibet Ripper	Form: OLWR-SWR-1A (04/08

I certify that the well/borehole was drilled, constructed, and completed in accordance with all applicable requirements of the Mississippi Department of Environmental Quality and the Mississippi Department of Health regulations, if applicable, and state

law (1711) \cap Date

Print Name of Responsible Licensee and License No.

Signature of Licensee



Distance Direction Miles Diesel Engine Ga Electric Motor Hi Windmill O Horse Power Rating of M	Sec
Electric Motor He Windmill O Horse Power Rating of M	Circle one asoline Engine Natural Gas land Tractor PTO other (specify):
Number of Stages:	feet
Air Line Electric	of Measuring Water Level Circle one c Measuring Line Steel Tape
Well yielded	red shut in head:feet GPM with a drawdown of afterhours of pumping
isting Pump Repair	r of Existing Pump
of my knowledge.	ump Installer Form: OLWR-SWR-1C (07-09
	For flowing well, measu Well yielded

.