

1183

BFU 5-4 #1A

# STATE WELL REPORT

## Part 1

### Driller's Log

Mississippi Department of Environmental Quality  
Office of Land and Water Resources  
P.O. Box 2309  
Jackson, MS 39225-2309  
(601)961-5210  
(601)360-0535 (fax)

#### For Office Use Only:

Well #: G578  
Aquifer: \_\_\_\_\_  
E-Log #: \_\_\_\_\_

County: Lincoln  
 Permit #: \_\_\_\_\_  
 Driller: John W Thompson  
 Date drilling completed: 1-31-17

State Law requires that this report be prepared by the license holder responsible for the work and filed with the Department at the above address within 30 days of completion of drilling of the well or borehole.

Well Owner Information <small>(Landowner if borehole is not for a water well)</small>			Well or Borehole Location		
Owner Name: <u>Denbury Onshore</u>			Latitude: <u>31° 36' 35.8"</u> Longitude: <u>90° 31' 46.5"</u>		
Mailing Address: <u>P.O. Box 6506</u> <u>Laurel MS</u>			Method of Lat/Long (check one): Conventional Survey _____		
City _____ State _____ Zip Code _____			USGS quad _____, Hand-held GPS _____, Survey-grade GPS _____		
Telephone No. (____) _____			<u>NW</u> $\frac{1}{4}$ <u>NW</u> $\frac{1}{4}$ , Sec <u>5</u> T <u>7N</u> R <u>7E</u> <u>5</u> Miles <u>W</u> of <u>Brookhaven</u> (Distance) (Direction) (Nearest Town)		

**Well / Borehole Data**

Date drilling started: 1-30-17 Date drilling completed: 1-31-17 Hole depth: 340 Hole diameter: 7

Location of the source of any surface water used for drilling: Creek

Method of dosing and volume of Chlorine used in drilling and development: added 6 gallons bleach

Logs run (circle all applicable): No log run Electric Gamma Ray Density Sonic Neutron Other: \_\_\_\_\_

Name of organization running log(s): \_\_\_\_\_

Purpose of borehole (circle one): Water Well Geotechnical/Geological Investigation Ground Source Heat Pump  
 Seismic Survey Other (describe) \_\_\_\_\_

*If drilling is not related to water well construction, skip the remainder of this block*

Purpose of Well (circle all applicable): Home Industrial Public Supply Irrigation Fish Culture  
 Other (describe): rig supply

If a flowing well, method of flow regulation: Valve \_\_\_\_\_ Other (describe) \_\_\_\_\_

Static Water Level: 168 feet [above or below land surface] (circle one) Date measured: 1-31-17

Method of measurement (circle one): Steel tape Electric tape Air line Other (describe) \_\_\_\_\_

Well depth: 330 Well grouted to a depth of: 20 feet Type of grout (circle one): Neat Cement Bentonite Mix

Casing length: 270 feet Casing diameter: 4 inches Type of casing: PVC

Screen length: 60 feet Screen diameter: 4 inches Type of screen: PVC slotted

Screen slot size: .008 inches Setting depth: From 270 feet to 330 feet

Type of completion (circle all applicable): Gravel packed Underreamed Open hole Natural Development

Other (describe): \_\_\_\_\_

Top of lap pipe or reduction in casing: \_\_\_\_\_ feet

*If telescoped or more than one screen, describe on next page*

RECEIVED  
FEB 17 2017

BY OLI



# STATE WELL REPORT

## Part 2

**Pump Installer's Completion Report**  
 Mississippi Department of Environmental Quality  
 Office of Land and Water Resources  
 P.O. Box 2309  
 Jackson, MS 39225-2309  
 (601)961-5210  
 (601) 360-0535 (fax)

County: Lincoln  
 Permit #: \_\_\_\_\_  
 Driller: John W Thompson  
 Date completed: 1-31-17  
**Copy information from block on Part 1**

**For Office Use Only:**

Well #: 6578  
 Aquifer: \_\_\_\_\_

*This part of the report must be completed by a licensed water well contractor or a licensed pump installer. A copy of Part 1 of the report must be attached and both parts filed with the Department at the above address within 30 days of well completion.*

Well Owner Information			Well Location		
Owner Name: <u>Danbury Onshore</u>			Latitude: <u>31°36'35.8"</u> Longitude: <u>90°31'46.5"</u>		
Mailing Address: <u>P.O. Box 16506</u> <u>Laurel MS</u>			Method of Lat/Long (check one): Conventional Survey _____, USGS quad _____, Hand-held GPS _____, Survey-grade GPS _____		
City	State	Zip Code	<u>NW 1/4 NW 1/4, Sec 5 T 7N R 7E</u>		
Telephone No. (____) _____			<u>5</u> Miles <u>W</u> of <u>Brookhaven</u> (Distance) (Direction) (Nearest Town)		

**Pump Type (circle one)**

Submersible  Turbine  Air Lift  Centrifugal  Flowing Well  Jet  Piston  Rotary  Other (describe): \_\_\_\_\_

Date Pump Installed: 1-31-17 Rated Pump Capacity: 55 Gallons Per Minute

Is This Pump (circle one):  New  Repaired  Replacement

**Power Type (circle one)**

Electric  Diesel  Gasoline  Natural Gas  Tractor PTO  Windmill  Other (describe): \_\_\_\_\_

Horse Power Rating of Motor: 5 Setting Depth: 200 feet Number of Stages: \_\_\_\_\_

**Pump Test Data for Non Flowing Well**

Date Well Tested: 1-31-17 Duration of Pump Test (minimum 4 hours): 4 hours

Static Water Level (A): 168 Feet Below Land Surface Pumping Water Level (B): 175 Feet Below Land Surface

Drawdown [(B) - (A)]: 7 Feet Below Land Surface Test Pumping Rate: 50 Gallons Per Minute

Method of measurement (circle one): Steel tape  Electric tape   Air line  Other (describe): \_\_\_\_\_

**Pump Test Data for Flowing Well**

Measured shut in head: \_\_\_\_\_ feet.

Well yielded \_\_\_\_\_ GPM with a drawdown of \_\_\_\_\_ feet after \_\_\_\_\_ hours of pumping

**Meter Installation**

Meter Manufacturer: \_\_\_\_\_ Meter Serial Number: \_\_\_\_\_

Meter Model Number/Name: \_\_\_\_\_ Type of Meter: \_\_\_\_\_

Totalizer Register Unit and Multiplier Factor (AF x .001, gal x 1000, etc): \_\_\_\_\_

Installation Date: \_\_\_\_\_ Meter installed by: \_\_\_\_\_

Is This Meter (circle one):  New  Repaired  Replacement

**RECEIVED**  
**FEB 17 2017**


*Important: By submitting the above information you are certifying that this meter was installed to manufacturer standards. For agricultural wells, a list of approved meters is on the MDEQ website.*

I HEREBY CERTIFY that the above statements are true to the best of my knowledge.

John W Thompson 0-679 1-31-17 John W Thompson  
 Print Name of Pump Installer and License No. (if applicable) Date Signature of Pump Installer

G578

# Google Maps 31°36'35.8"N 90°31'46.5"W

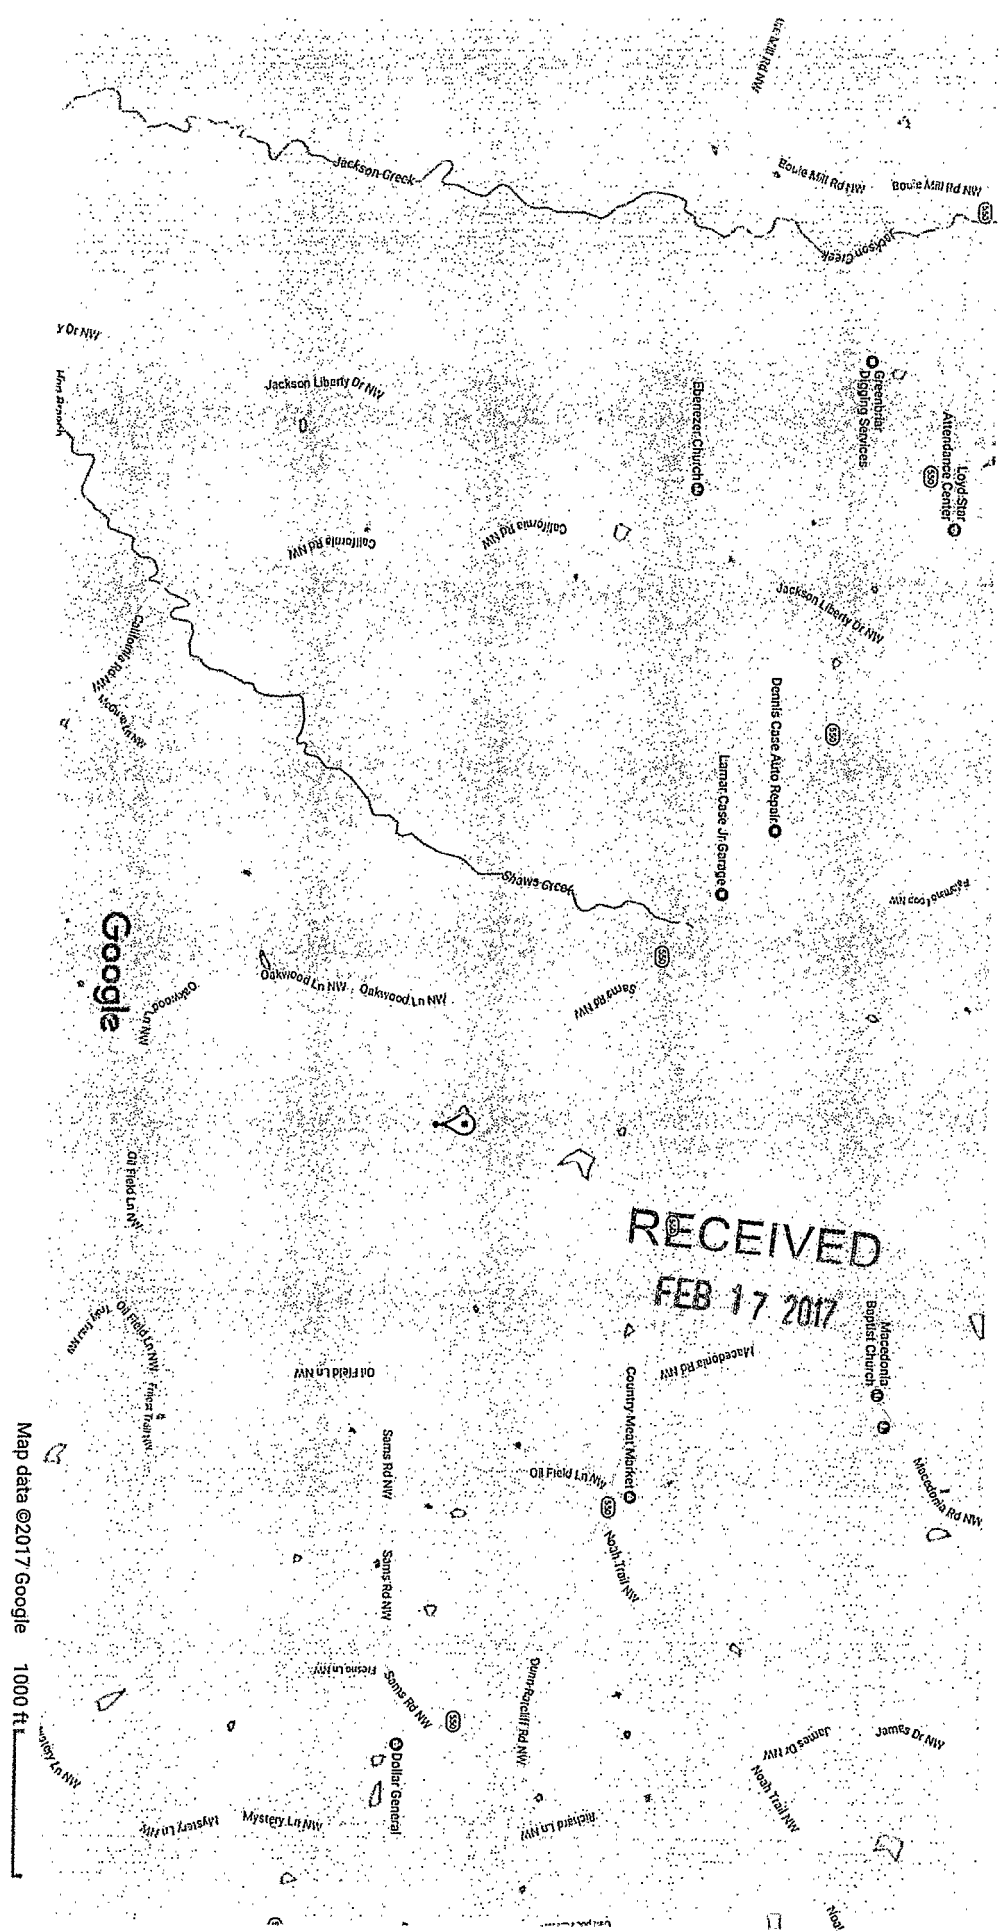

RECEIVED  
FEB 17 2017

Map data ©2017 Google 1000 ft

https://www.google.com/maps/place/31%C2%B036'35.8°N+90%C2%B031'46.5°W/@31.6130454,-90.5360001,15z/data=!4m5!3m4!1s0x0:0x0:018m2!3d31.60994814d-90.529695