

LINCOLN
G
3/7/78
2000

**MISSISSIPPI  
BOARD OF WATER COMMISSIONERS**  
416 North State Street  
Jackson, Mississippi 39201

**WATER WELL DRILLERS LOG**

1978
Mar. 7
Grenn Water Well Cont.
Lincoln  
date well completed
firm name
county well located

**LANDOWNER:** Donald Campbell  
Route 2  
Brookhaven  
(mailing address)

description of formations encountered	from	to
Citronelle	1	52

**WELL LOCATION:**  
 sec. 22 T. 2 N. R. 7 E.  
           7 S.                    W  
1 miles W of Brookhaven  
 (distance) (direction) (nearest town)  
   home in

**WELL PURPOSE:** housing development  
 (home, irrigation, municipal, industrial)

- WELL COMPLETION DATA:**
- (1) diameter (inches) 6"
  - (2) total depth (feet) 52'
  - (3) static water level (feet) 18 below top of ground.
  - (4) casing PVC 40  
           (material) (depth)  
4"  
           (size) if telescope see back.
  - (5) screen 12' 40'  
           (length) (depth to top)  
.010 PVC  
           (size) (material)
  - (6) pump 3/4 HP. Sub 10  
           (HP) (yield gpm)  
           electricity  
           (type power)
  - (7) electric log no  
           (yes or no)
- (organization running log) \_\_\_\_\_

(8) how well bottom plugged  
backwash valve


**DRILLERS REMARKS:**

**RECEIVED**  
 APR 17 1978

MISS. Bd. OF WATER COMMISSIONERS

If well telescopes please sketch and show depths.

GROUND LEVEL

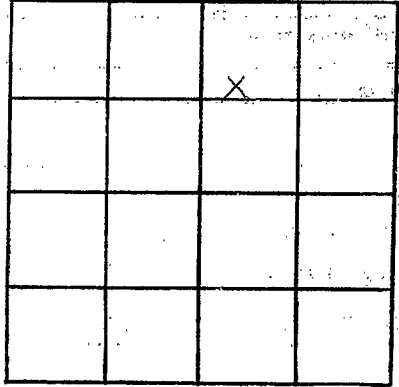

SECTION 22

Please indicate well location X.

ADDITIONAL INFORMATION

Lined area for additional information.

If more than one screen, show locations of each on sketch.