

Lincoln
G
2002

MISSISSIPPI DEPARTMENT OF NATURAL RESOURCES
Bureau of Land and Water Resources
Southport Mall
P.O. Box 10631
Jackson, Mississippi 39209
WATER WELL DRILLERS LOG

June 21 19 84 Glenn Water Well Lincoln
date well completed firm name county well located

LANDOWNER: Van Alexander
523 Laird Circle
Brookhaven, Ms.
(mailing address)

description of formations encountered	from	to
	Citronelle	1

WELL LOCATION:
sec. 34 T 7 N R 7 E
S W
2 miles SW of Brookhaven
(distance) (direction) (nearest town)

WELL PURPOSE: home
(home, irrigation, municipal, industrial)

- WELL COMPLETION DATA:
- (1) diameter (inches) 4
 - (2) total depth (feet) 83
 - (3) static water level (feet) 58 below top of ground.
 - (4) casing PVC, 73' (material) (depth)
4" (size) if telescope see back.
 - (5) screen 10' (length), 73' (depth to top)
.010 PVC (size) (material)
 - (6) pump did not install (HP) (yield gpm)
(type power)
 - (7) electric log no (yes or no)
(organization running log)
 - (8) how well bottom plugged back wash valve

DEPT. OF NATURAL RESOURCES
BUREAU OF LAND & WATER RESOURCES


SEP 18 1984

RECEIVED

DRILLERS REMARKS:

If well telescopes please sketch and show depths.

GROUND LEVEL

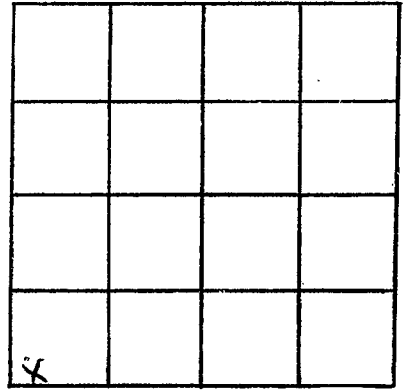

SECTION 34

Please indicate well location X.

ADDITIONAL INFORMATION

If more than one screen,
show locations of each on sketch.