

LINCOLN
G
2007

MISSISSIPPI DEPARTMENT OF NATURAL RESOURCES
 Bureau of Land and Water Resources
 Southport Mall
 P.O. Box 10631
 Jackson, Mississippi 39209
WATER WELL DRILLERS LOG

May 10 19 86 Gretn Water Well Lincoln
 date well completed firm name county well located

LANDOWNER: Mark Smith
P.O. Box 103
Brookhaven, Ms.
 (mailing address)

description of formations encountered
Citronelle
 from 1 to 78

WELL LOCATION:
 sec. 22 T 7 N R 7 E
S W
1 miles SW of Brookhaven
 (distance) (direction) (nearest town)

WELL PURPOSE: home
 (home, irrigation, municipal, industrial)

- WELL COMPLETION DATA:
- (1) diameter (inches) 4
 - (2) total depth (feet) 78
 - (3) static water level (feet) 48 below top of ground.
 - (4) casing PVC, 68'
 (material) (depth)
4" if telescope see back.
 (size)
 - (5) screen 10', 68'
 (length) (depth to top)
.010, PVC
 (size) (material)
 - (6) pump 1/2 sub 10
 (HP) (yield gpm)
electricity
 (type power)
 - (7) electric log no
 (yes or no)
(organization running log)
 - (8) how well bottom plugged back wash valve


RECEIVED
 JUN 27 1986

Department of Natural Resources
 Bureau of Land & Water Resources

DRILLERS REMARKS:

If well telescopes please sketch and show depths.

GROUND LEVEL

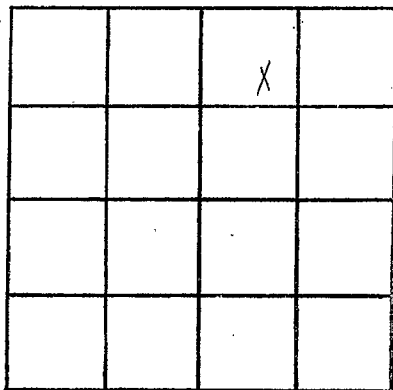

SECTION 22

Please indicate well location X.

ADDITIONAL INFORMATION

If more than one screen,
show locations of each on sketch.