

MISSISSIPPI DEPARTMENT OF NATURAL RESOURCES
Bureau of Land and Water Resources
Southport Mall
P.O. Box 10631
Jackson, Mississippi 39209
WATER WELL DRILLERS LOG

Lincoln
G
2008

Jan. 13 19 86 Grenn Water Well Lincoln
date well completed firm name county well located

LANDOWNER: Joe Albritton

Route 5
Brookhaven, Ms.
(mailing address)

WELL LOCATION:
sec. 26 T 7 N R 7 E
S W

1 miles south of Brookhaven
(distance) (direction) (nearest town)

WELL PURPOSE: home
(home, irrigation, municipal, industrial)

WELL COMPLETION DATA:

description of formations encountered	from	to
Clay	1	20
sand & gravel	20	60
white clay	60	80
blue clay	80	110
white clay	110	120
sand	120	168

(1) diameter (inches) 4

(2) total depth (feet) 168

(3) static water level (feet) 48 below
top of ground.

(4) casing PVC 158'
(material) (depth)
4"
(size) If telescope see back.

(5) screen 10' 158'
(length) (depth to top)
.010 PVC
(size) (material)

(6) pump 1/2 sub 10
(HP) (yield gpm)
electricity
(type power)

(7) electric log no
(yes or no)
(organization running log)


(8) how well bottom plugged back wash valve

DRILLERS REMARKS:

RECEIVED
FEB 27 1986
Department of Natural Resources
Bureau of Land & Water Resources

If well telescopes please
sketch and show depths.

GROUND LEVEL

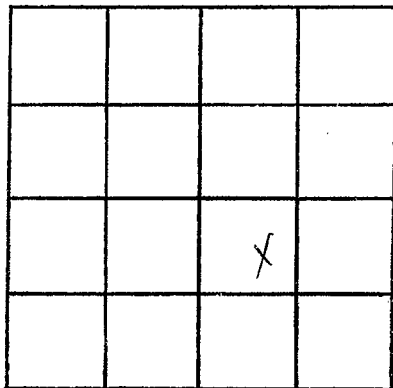

SECTION 26

Please indicate well location X.

ADDITIONAL INFORMATION

If more than one screen,
show locations of each on sketch.