

Bureau of Land and Water Resources

Jackson, MS 39289-0631

WATER WELL DRILLERS LOG

COUNTY WELL LOCATED <i>Lincoln</i>		MISSISSIPPI DEPT. OF REVENUE	
WELL NUMBER <i>G 2010</i>	CODED	PERMIT NUMBER	
		NAME OF DRILLING FIRM <i>Green Water Well Co</i>	
DATE WELL COMPLETED <i>5-23-94</i>		<i>Sumola</i>	

NAME & MAILING ADDRESS OF LANDOWNER

Kenneth Magee

Rt 2 River Rd SE

Boque Chitto ms

WELL LOCATION	SEC	TOWNSHIP	RANGE
	36	7 N	7 W

DISTANCE	DIRECTION	NEAREST TOWN
2 Miles	South	of Brookhaven

OTHER LANDMARK

WELL PURPOSE: Home Irrigation, Municipal, Industrial, Fish Pond, etc.

PUMP DATA

PUMP TYPE (Circle One):
Submersible Turbine, Jet Flowing Well,
 Other (Describe) _____

PUMP TYPE (Circle One):
Electric Tractor, Diesel, Gasoline, Butane,
 Other (Describe) _____ H/P 1

Pump Capacity (GPM) <u>16</u>	No. of Stages <u>10</u>	Setting Depth <u>95</u> FT.
----------------------------------	----------------------------	--------------------------------

PUMP TEST

Well yielded 16 GPM with
 a drawdown of 0 ft.
 after 1 hours of pumping

WELL DATA

Well Depth 150	Casing Diameter (In.) 4 in.	Casing Length (Ft.) 140
Type of Casing PVC	Hole Depth 157	Depth to Static Water Level 65
TYPE OF COMPLETION: (Circle One or More): <input checked="" type="checkbox"/> Gravel Packed <input type="checkbox"/> Underreamed, <input type="checkbox"/> Telescoped, <input type="checkbox"/> Natural Development, <input type="checkbox"/> Open Hole, <input type="checkbox"/> Other (Describe) _____		
Top of Lap Pipe or Reduction in Casing <div style="display: flex; justify-content: space-between; align-items: center;"> FEET <div style="border: 1px solid black; padding: 5px; text-align: center;"> IF TELESCOPED OR MORE THAN ONE SCREEN: USE BACK PAGE </div> </div>		

LOG DATA

TYPE OF LOG RUN (Circle One): No Log Run
Electric, Gamma Ray, Density, Sonic, Neutron,
Other (Describe) _____

Name of Organization Running Log _____


GEOLOGIC DATA (Office Use Only)

Surface Elev.	Geologic Unit	Unit Thickness	Depth to Top
Subs. SWL	Date	Analysis	Aquifer Test

Driller's Remarks


SCREEN DATA

Diameter - Inches 4 in.	Length - Feet 10 ft.	Slot Size - Inches .010
Screen Type PVC		Depth to Bottom - Feet 150

DESCRIPTION OF FORMATIONS ENCOUNTERED	FROM	TO	FORMATIONS (Continued)	FROM	TO
red sandy clay	0	20			
sand	20	40			
red clay	40	53			
sand	53	67			
sand & Gravel	67	97			
white clay	97	106			
sand	106	157	Dept. of Environmental Quality Office of Land & Water Resources		
			IF MORE SPACE IS NEEDED, USE BACK		

If well telescopes please
sketch and show depths.

GROUND LEVEL

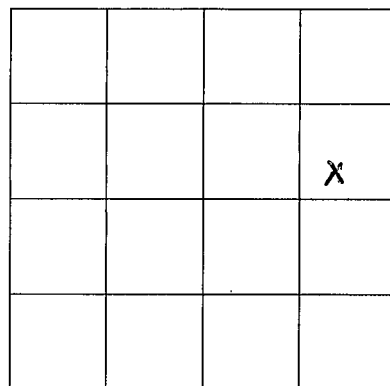

SECTION 36

Please indicate well location X.

ADDITIONAL INFORMATION

If more than one screen,
show location of each on sketch.