

MISSISSIPPI DEPARTMENT OF NATURAL RESOURCES

Bureau of Land and Water Resources

COUNTY WELL LOCATED <i>Linedown</i>	
WELL NUMBER 298814	CODED
<i>G 2057</i>	
DATE WELL COMPLETED 6-27-95	

PERMIT NUMBER 510
NAME OF DRILLING FIRM Easley Water Wells
Brookhaven, MS 39601

P.O. Box 10631
Jackson, Mississippi 39209
WATER WELL DRILLERS LOG

NAME & MAILING ADDRESS OF LANDOWNER Mr. Mullins			
WELL LOCATION:	SEC	TOWNSHIP	RANGE
	<i>16</i>	<i>7</i> N	<i>7</i> E
		<i>S</i>	<i>W</i>
DISTANCE	DIRECTION	NEAREST TOWN	
_____ Miles	_____ of _____	_____	
OTHER LANDMARK			
WELL PURPOSE: Home, Irrigation, Municipal, Industrial, Fish Pond, etc.			

PUMP DATA		
PUMP TYPE (Circle One): Submersible Turbine, Jet Flowing Well, Other (Describe) _____		
POWER TYPE (Circle One): Electric Tractor, Diesel, Gasoline, Butane, Other (Describe) _____		
Pump Capacity (GPM)	No. of Stages	Setting Depth
_____	_____	_____ FT.
PUMP TEST		
Well yielded _____ GPM with a drawdown of _____ ft. after _____ hours of pumping		

WELL DATA		
Well Depth 160'	Casing Diameter (In.) 4"	Casing Length (Ft.) 140
Type of Casing <i>pvc</i>	Hole Depth 160	Depth to Static Water Level
TYPE OF COMPLETION: (Circle One or More): Gravel Packed, Underreamed, Telescoped, Natural Development, Open Hole, Other		
Top of Lap Pipe or Reduction in Casing		
FEET	IF TELESCOPED OR MORE THAN ONE SCREEN: USE BACK PAGE	


LOG DATA	
TYPE OF LOG RUN (Circle One): No Log Run, Electric, Gamma Ray, Density, Sonic, Neutron, Other (Describe) _____	
Name of Organization Running Log	

SCREEN DATA		
Diameter - Inches 4"	Length - Feet 20	Slot Size - Inches 10
Screen Type <i>pvc</i>	Depth to Bottom - Feet 160	

GEOLOGIC DATA (Office Use Only)			
Surface Elev.	Geologic Unit	Unit Thickness	Depth to Top
Subs. SWL	Date	Analysis	Aquifer Test

Driller's Remarks

DESCRIPTION OF FORMATIONS ENCOUNTERED	FROM	TO
<i>Clay</i>	<i>0</i>	<i>20</i>
<i>Gravel</i>	<i>20</i>	<i>80</i>
<i>Clay</i>	<i>80</i>	<i>140</i>
<i>Sand</i>	<i>140</i>	<i>160</i>

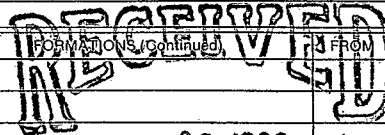

JUL 02 1996

Dept. of Environmental Quality
Office of Land & Water Resources

FORMATIONS (Continued)	FROM	TO

IF MORE SPACE IS NEEDED, USE BACK

