

MISSISSIPPI DEPARTMENT OF NATURAL RESOURCES

Bureau of Land and Water Resources

COUNTY WELL LOCATED <i>Lincoln</i>	
WELL NUMBER 298822	CODED
<i>G-2058</i>	
DATE WELL COMPLETED 8-14-95	

PERMIT NUMBER 510
NAME OF DRILLING FIRM Easley Water Wells
Brookhaven, MS 39601

P.O. Box 10631
Jackson, Mississippi 39209
WATER WELL DRILLERS LOG

NAME & MAILING ADDRESS OF LANDOWNER Chad Greer			
WELL LOCATION:	SEC	TOWNSHIP	RANGE
	<i>19</i>	<i>7</i> N	<i>7</i> E
		S	W
DISTANCE	DIRECTION	NEAREST TOWN	
_____ Miles	_____ of _____	_____	
OTHER LANDMARK			
WELL PURPOSE: Home, Irrigation, Municipal, Industrial, Fish Pond, etc.			

PUMP DATA		
PUMP TYPE (Circle One):		
<input checked="" type="radio"/> Submersible,	Turbine,	Jet Flowing Well,
Other (Describe) _____		
POWER TYPE (Circle One):		
<input checked="" type="radio"/> Electric	Tractor,	Diesel, Gasoline, Butane,
Other (Describe) _____		
Pump Capacity (GPM)	No. of Stages	Setting Depth
_____	_____	_____ FT.
PUMP TEST		
Well yielded _____ GPM with		
a drawdown of _____ ft.		
after _____ hours of pumping		

WELL DATA		
Well Depth 100'	Casing Diameter (in.) 4"	Casing Length (Ft.) 80
Type of Casing PVC	Hole Depth 100	Depth to Static Water Level
TYPE OF COMPLETION: (Circle One or More):		
<input type="checkbox"/> Gravel Packed,	<input type="checkbox"/> Underreamed,	<input type="checkbox"/> Telescoped,
<input type="checkbox"/> Natural Development,	<input type="checkbox"/> Open Hole,	<input type="checkbox"/> Other
(Describe) _____		
Top of Lap Pipe or Reduction in Casing		
FEET	IF TELESCOPED OR MORE THAN ONE SCREEN: USE BACK PAGE	

LOG DATA	
TYPE OF LOG-RUN: (Circle One):	
<input type="checkbox"/> No Log-Run,	<input type="checkbox"/> Electric, Gamma Ray, Density, Sonic, Neutron,
Other (Describe) _____	
Name of Organization Running Log	

SCREEN DATA		
Diameter - Inches 4"	Length - Feet 20	Slot Size - Inches 12
Screen Type PVC	Depth to Bottom - Feet 100	

GEOLOGIC DATA (Office Use Only)			
Surface Elev.	Geologic Unit.	Unit Thickness	Depth to Top
Subs. SWL	Date	Analysis	Aquifer Test

Driller's Remarks

DESCRIPTION OF FORMATIONS ENCOUNTERED	FROM	TO
<i>Clay</i>	<i>0</i>	<i>20</i>
<i>Gravel</i>	<i>20</i>	<i>80</i>
<i>Sand</i>	<i>80</i>	<i>100</i>

RECEIVED


JUL 02 1996

Dept. of Environmental Quality
Office of Land & Water Resources

IF MORE SPACE IS NEEDED, USE BACK

If well telescopes please
sketch and show depths.

GROUND LEVEL

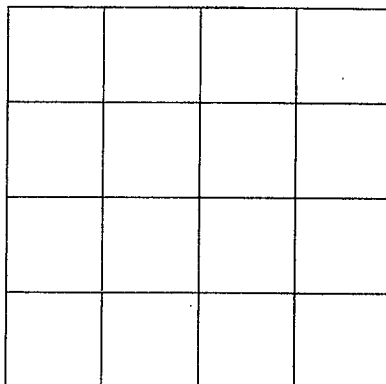

SECTION _____

Please indicate well location X.

ADDITIONAL INFORMATION

If more than one screen,
show location of each on sketch.