

MISSISSIPPI DEPARTMENT OF ENVIRONMENTAL QUALITY

Office of Land and Water Resources

P. O. Box 10631

Jackson, MS 39289-0631

WATER WELL DRILLERS LOG

COUNTY WELL LOCATED <u>Lincoln</u>	
WELL NUMBER <u>G 2067</u>	CODED
DATE WELL COMPLETED <u>9-6-96</u>	

PERMIT NUMBER Grinn Water Well & Supply
NAME OF 1318 Pricedale Dr. SE Bogue Chitto, MS 39629

NAME & MAILING ADDRESS OF LANDOWNER <u>Carl Aycock</u>			
<u>P.O. Box 1276</u>			
<u>Brookhaven MS 39601</u>			
WELL LOCATION:	SEC	TOWNSHIP	RANGE
	<u>26</u>	<u>7</u> <u>N</u>	<u>7</u> <u>E</u>
DISTANCE	DIRECTION	NEAREST TOWN	
<u>1</u> Miles	<u>S</u>	of <u>Brookhaven</u>	
OTHER LANDMARK			
WELL PURPOSE: Home, Irrigation, Municipal, Industrial, <u>Fish Pond</u> etc.			

PUMP DATA			
PUMP TYPE (Circle One): <u>Submersible</u> , Turbine, Jet, Flowing Well, Other (Describe) _____			
POWER TYPE (Circle One): <u>Electric</u> , Tractor, Diesel, Gasoline, Butane, Other (Describe) _____ H/P <u>1</u>			
Pump Capacity (GPM)	No. of Stages	Setting Depth	
<u>25</u>	<u>7</u>	<u>60</u> FT.	
PUMP TEST			
Well yielded <u>25</u> GPM with a drawdown of <u>10</u> ft. after <u>1</u> hours of pumping			


WELL DATA		
Well Depth <u>135</u>	Casing Diameter (In.) <u>4 in.</u>	Casing Length (Ft.) <u>125</u>
Type of Casing <u>PVC</u>	Hole Depth <u>144</u>	Depth to Static Water Level <u>22</u>
TYPE OF COMPLETION: (Circle One or More): <u>Gravel Packed</u> , Underreamed, Telescoped, Natural Development, Open Hole, Other (Describe) _____		
WELL GROUTED TO A DEPTH OF <u>10</u> FEET Type Grout (circle one): Cement, Bentonite, or <u>Mix</u>		

LOG DATA	
TYPE OF LOG RUN (Circle One): <u>No Log Run</u> Electric, Gamma Ray, Density, Sonic, Neutron, Other (Describe) _____	
Name of Organization Running Log	

SCREEN DATA		
Diameter - Inches <u>4 in.</u>	Length - Feet <u>10 ft.</u>	Slot Size - Inches <u>.010</u>
Screen Type <u>PVC</u>	Depth to Bottom - Feet <u>135 ft.</u>	


GEOLOGIC DATA (Office Use Only)			
Surface Elev.	Geologic Unit	Unit Thickness	Depth to Top
Subs. SWL	Date	Analysis	Aquifer Test
Driller's Remarks			
Top of Lap Pipe or Reduction in Casing			
FEET		IF TELESKOPED OR MORE THAN ONE SCREEN: USE BACK PAGE	

DESCRIPTION OF FORMATIONS ENCOUNTERED	FROM	TO
Red Clay	0	12
Sand & Gravel	12	50
White Clay	50	90
Sand	90	136
Clay	136	144

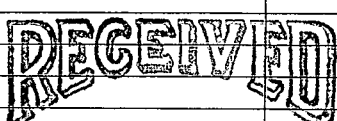FORMATIONS (Continued)		FROM	TO
			
FEB 07 1997			
Dept. of Environmental Quality Office of Land & Water Resources			
IF MORE SPACE IS NEEDED, USE BACK			

If well telescopes please
sketch and show depths.

GROUND LEVEL

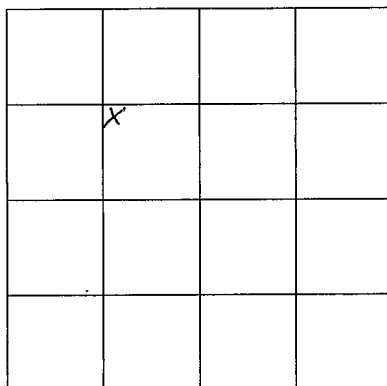

SECTION 26

Please indicate well location X.

ADDITIONAL INFORMATION

If more than one screen,
show location of each on sketch.