

MISSISSIPPI DEPARTMENT OF ENVIRONMENTAL QUALITY

Office of Land and Water Resources

P. O. Box 10631
Jackson, MS 39289-0631
WATER WELL DRILLERS LOG

COUNTY WELL LOCATED <u>Lincoln</u>	
WELL NUMBER <u>G 2096</u>	CODED
DATE WELL COMPLETED <u>12-14-98</u>	

PERMIT NUMBER Green Water Well & Supply
NAME OF DRILLING <u>1318 Pricedale Dr. SE</u> Bogue Chitto, MS 39629

NAME & MAILING ADDRESS OF LANDOWNER <u>Josh Wright</u> <u>2078 Rocky Hill Rd</u> <u>Wesson</u>			
WELL LOCATION:	SEC <u>33</u>	TOWNSHIP <u>7^N_S</u>	RANGE <u>7^E_W</u>
DISTANCE <u>2</u> Miles	DIRECTION <u>SW</u>	NEAREST TOWN <u>Brookhaven</u>	
OTHER LANDMARK			
WELL PURPOSE (Home) <input checked="" type="checkbox"/> Irrigation, Municipal, Industrial, Fish Pond, etc.			

PUMP DATA		
PUMP TYPE (Circle One): Submersible, Turbine, Jet, Flowing Well, Other (Describe) _____		
POWER TYPE (Circle One): Electric, Tractor, Diesel, Gasoline, Butane, Other (Describe) _____ H/P <u>1/2</u>		
Pump Capacity (GPM) <u>10</u>	No. of Stages <u>9</u>	Setting Depth <u>72</u> FT.
PUMP TEST Well yielded <u>10</u> GPM with a drawdown of <u>0</u> ft. after <u>1</u> hours of pumping		

WELL DATA		
Well Depth <u>73'</u>	Casing Diameter (In.) <u>4"</u>	Casing Length (Ft.) <u>63'</u>
Type of Casing <u>PVC</u>	Hole Depth <u>80'</u>	Depth to Static Water Level <u>40'</u>

LOG DATA	
TYPE OF LOG RUN (Circle One): Electric, Gamma Ray, Density, Sonic, Neutron, Other (Describe) _____ <u>No Log Run</u>	
Name of Organization Running Log	


TYPE OF COMPLETION: (Circle One or More):
 Gravel Packed, Underreamed, Telescoped,
 Natural Development, Open Hole, Other

GEOLOGIC DATA (Office Use Only)			
Surface Elev.	Geologic Unit	Unit Thickness	Depth to Top
Subs. SWL	Date	Analysis	Aquifer Test
Driller's Remarks			

WELL GROUTED TO A DEPTH OF 10 FEET
 Type Grout (circle one): Cement, Bentonite, Mix

SCREEN DATA		
Diameter - Inches <u>4"</u>	Length - Feet <u>10'</u>	Slot Size - Inches <u>.010</u>
Screen Type <u>PVC</u>	Depth to Bottom - Feet <u>73'</u>	
FEET		IF TELESCOPED OR MORE THAN ONE SCREEN: USE BACK PAGE

DESCRIPTION OF FORMATIONS ENCOUNTERED	FROM	TO
<u>Red Clay</u>	<u>0</u>	<u>58</u>
<u>Sand/Gravel</u>	<u>58</u>	<u>73</u>
<u>White Clay</u>	<u>73</u>	<u>80</u>

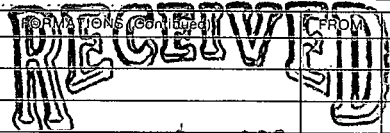 JAN 25 1999 Dept. of Environmental Quality Office of Land & Water Resources	
IF MORE SPACE IS NEEDED, USE BACK	

If well telescopes please sketch and show depths.


GROUND LEVEL

			X

SECTION 33

Please indicate well location X.

ADDITIONAL INFORMATION

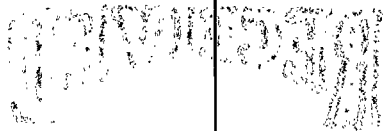

If more than one screen,
show location of each on sketch.