

1/21/00

MISSISSIPPI DEPARTMENT OF ENVIRONMENTAL QUALITY

Office of Land and Water Resources

COUNTY WELL LOCATED
Lincoln

WELL NUMBER
G-2128

CODED

DATE WELL COMPLETED
1-24-00

PEER REVIEWED
Green Water Well & Supply

1318 Pricedale Dr. SE
Bogue Chitto, MS 39629

NAME OF DRILLING FIRM

P. O. Box 10631
Jackson, MS 39289-0631
WATER WELL DRILLERS LOG

NAME & MAILING ADDRESS OF LANDOWNER
Evangelina Banks

787 Saints In NW

Brookhaven

WELL LOCATION: SEC TOWNSHIP RANGE
15 7 S 7 E

DISTANCE DIRECTION NEAREST TOWN
1 Miles **W** of **Brookhaven**

OTHER LANDMARK

WELL PURPOSE: Home Irrigation, Municipal, Industrial, Fish Pond, etc.

PUMP DATA

PUMP TYPE (Circle One):
Submersible, Turbine, Jet, Flowing Well,
Other (Describe) _____

POWER TYPE (Circle One):
Electric, Tractor, Diesel, Gasoline, Butane,
Other (Describe) _____ **1/2**

Pump Capacity (GPM) No. of Stages Setting Depth
10 9 85 FT.

PUMP TEST

Well yielded **10** GPM with
a drawdown of **10** ft.
after **1** hours of pumping

WELL DATA

Well Depth **90'** Casing Diameter (In.) **4"** Casing Length (Ft.) **80'**

Type of Casing **PVC** Hole Depth **100** Depth to Static Water Level **25'**

TYPE OF COMPLETION: (Circle One or More):
 Gravel Packed, Underreamed, Telescoped,
 Natural Development, Open Hole, Other
(Describe) _____

WELL GROUTED TO A DEPTH OF **10 FEET**
Type Grout (circle one): Cement, Bentonite, or Mix

LOG DATA

TYPE OF LOG RUN (Circle One): No Log Run
Electric, Gamma Ray, Density, Sonic, Neutron,
Other (Describe) _____

Name of Organization Running Log

SCREEN DATA

Diameter - inches **4** Length - Feet **10'** Slot Size - Inches **.010**

Screen Type **PVC** Depth to Bottom - Feet **90**

GEOLOGIC DATA (Office Use Only)

Surface Elev.	Geologic Unit	Unit Thickness	Depth to Top
Subs. SWL	Date	Analysis	Aquifer Test

Driller's Remarks

Top of Lap Pipe or Reduction in Casing
FEET IF TELESKOPIED OR MORE THAN ONE SCREEN - USE BACK PAGE

DESCRIPTION OF FORMATIONS ENCOUNTERED	FROM	TO	FORMATIONS (Continued)	FROM	TO
Red Sand	0	10			
Gravel	15	37			
sand Rock	37	38			
Sand	38	55			
Sand w/ Clay streaks	55	75			
Sand	75	90			
White Clay	90	100			

IF MORE SPACE IS NEEDED, USE BACK

If well telescopes please
sketch and show depths.


GROUND LEVEL

X			

SECTION 15

Please indicate well location X.

ADDITIONAL INFORMATION

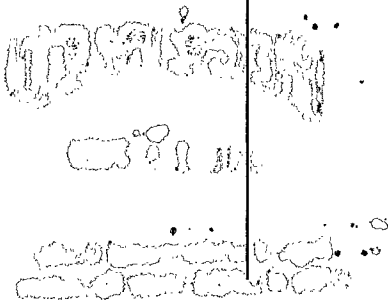

If more than one screen,
show location of each on sketch.