

MISSISSIPPI DEPARTMENT OF ENVIRONMENTAL QUALITY

Office of Land and Water Resources

P. O. Box 10631
Jackson, MS 39289-0631

WATER WELL DRILLERS LOG

COUNTY WELL LOCATED <u>Lincoln</u>	
WELL NUMBER <u>G-2147</u>	CODED
DATE WELL COMPLETED <u>11-14-00</u>	

PERMIT NUMBER <u>Green Water Well & Supply</u>
NAME OF DRILLING ORGANIZATION <u>Dr. 5E</u> <u>Boque Chitto, MS 39029</u>

NAME & MAILING ADDRESS OF LANDOWNER <u>Steve Kincaid</u> <u>P.O. Box 510</u> <u>Brookhaven MS</u>			
WELL LOCATION	SEC <u>35</u>	TOWNSHIP <u>7 N</u>	RANGE <u>7 E</u>
DISTANCE <u>3</u> Miles	DIRECTION <u>South</u>	NEAREST TOWN <u>Brookhaven</u>	
OTHER LANDMARK			
WELL PURPOSE <u>(Home)</u> Irrigation, Municipal, Industrial, Fish Pond, etc.			

PUMP DATA		
PUMP TYPE (Circle One): Submersible, Turbine, Jet, Flowing Well, Other (Describe) _____		
POWER TYPE (Circle One): Electric, Tractor, Diesel, Gasoline, Butane, Other (Describe) _____ H/P <u>1/2</u>		
Pump Capacity (GPM) <u>10</u>	No of Stages <u>9</u>	Setting Depth <u>65</u> FT.
PUMP TEST		
Well yielded <u>12</u> GPM with a drawdown of <u>0</u> ft. after <u>1</u> hours of pumping		

WELL DATA		
Well Depth <u>150</u>	Casing Diameter (In.) <u>4</u>	Casing Length (Ft.) <u>140</u>
Type of Casing <u>PVC</u>	Hole Depth <u>160</u>	Depth to Static Water Level <u>35</u>

LOG DATA			
TYPE OF LOG RUN (Circle One): Electric, Gamma Ray, Density, Sonic, Neutron, Other (Describe) _____ <u>No Log Run</u>			
Name of Organization Running Log			

TYPE OF COMPLETION: (Circle One or More):
 Gravel Packed, Underreamed, Telescoped,
 Natural Development, Open Hole, Other
 (Describe) _____

WELL GROUTED TO A DEPTH OF 10 FEET
 Type Grout (circle one): Cement, Bentonite, or Mix

GEOLOGIC DATA (Office Use Only)			
Surface Elev	Geologic Unit	Unit Thickness	Depth to Top
Subs SWL	Date	Analysis	Aquifer Test

SCREEN DATA		
Diameter - Inches <u>4</u>	Length - Feet <u>10</u>	Slot Size - Inches <u>.010</u>
Screen Type <u>PVC</u>	Depth to Bottom - Feet <u>150</u>	

Driller's Remarks	
Top of Lap Pipe or Reduction in Casing	
FEET	IF TELESCOPED OR MORE THAN ONE SCREEN: USE BACK PAGE

DESCRIPTION OF FORMATIONS ENCOUNTERED	FROM	TO	FORMATIONS (Continued)	
			FROM	TO
<u>Red Clay</u>	<u>0</u>	<u>16</u>		
<u>Sand & Gravel</u>	<u>16</u>	<u>56</u>		
<u>White Clay</u>	<u>56</u>	<u>77</u>		
<u>Sand & Gravel</u>	<u>77</u>	<u>160</u>		

MISSISSIPPI DEPARTMENT OF ENVIRONMENTAL QUALITY
OFFICE OF LAND AND WATER RESOURCES


MAR 19 2001

MISSISSIPPI DEPARTMENT OF ENVIRONMENTAL QUALITY
OFFICE OF LAND AND WATER RESOURCES

IF MORE SPACE IS NEEDED, USE BACK

If well telescopes please
sketch and show depths.

GROUND LEVEL

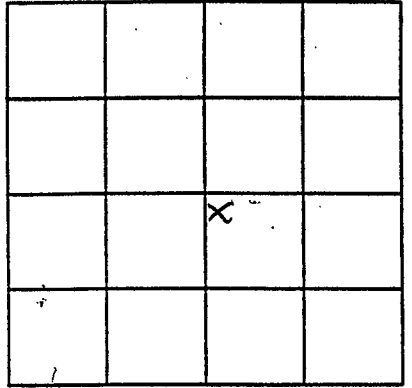

SECTION 35

Please indicate well location X.

ADDITIONAL INFORMATION

A series of horizontal lines providing space for additional information.

If more than one screen,
show location of each on sketch.