

MISSISSIPPI DEPARTMENT OF ENVIRONMENTAL QUALITY

QUALITY

Office of Land and Water Resources

COUNTY WELL LOCATED <i>Leflore</i>	
WELL NUMBER G 2151	CODED
DATE WELL COMPLETED 5/4/01	

Green Water Well & Supply
1318 Pricedale Dr. SE
Bogue Chitto, MS 39629

P. O. Box 10631
 Jackson, MS 39289-0631
WATER WELL DRILLERS LOG

NAME & MAILING ADDRESS OF LANDOWNER

Gene Butler

2215 Cade Ln NW

Brookhaven

WELL LOCATION: SEC 1 TOWNSHIP 7 RANGE 7

DISTANCE 1/4 Miles DIRECTION North of NEAREST TOWN Brookhaven

OTHER LANDMARK

WELL PURPOSE: Home Irrigation, Municipal, Industrial, Fish Pond, etc.

PUMP DATA

PUMP TYPE (Circle One): Submersible, Turbine, Jet, Flowing Well, Other (Describe)

POWER TYPE (Circle One): Electric, Tractor, Diesel, Gasoline, Butane, Other (Describe) H/P

Pump Capacity (GPM) No. of Stages Setting Depth FT.

PUMP TEST

Well yielded _____ GPM with a drawdown of _____ ft. after _____ hours of pumping

WELL DATA

Well Depth 120	Casing Diameter (In.) 4	Casing Length (Ft.) 110'
Type of Casing PVC	Hole Depth 130'	Depth to Static Water Level 45

TYPE OF COMPLETION: (Circle One or More): Gravel Packed, Underreamed, Telescoped, Natural Development, Open Hole, Other (Describe)

LOG DATA

TYPE OF LOG RUN (Circle One): No Log Run, Electric, Gamma Ray, Density, Sonic, Neutron, Other (Describe)

Name of Organization Running Log

WELL GROUTED TO A DEPTH OF 10 FEET

Type Grout (circle one): Cement, Bentonite, or Mix

GEOLOGIC DATA (Office Use Only)

Surface Elev.	Geologic Unit	Unit Thickness	Depth to Top
Subs. SWL	Date	Analysis	Aquifer Test

Driller's Remarks

Top of Lap Pipe or Reduction in Casing

FEET IF TELESCOPED OR MORE THAN ONE SCREEN: USE BACK PAGE

SCREEN DATA

Diameter Inches 4	Length - Feet 10'	Slot Size - Inches .010
Screen Type PVC	Depth to Bottom - Feet 120	


DESCRIPTION OF FORMATIONS ENCOUNTERED	FORMATIONS (Continued)		FROM	TO
	FROM	TO		
<i>Red Clay</i>	<i>0</i>	<i>18</i>		
<i>Streaky</i>	<i>18</i>	<i>30</i>		
<i>Sand & Gravel</i>	<i>30</i>	<i>120</i>		
<i>Yellow Clay</i>	<i>120</i>	<i>130</i>		

RECD JUN 13 2001

IF MORE SPACE IS NEEDED, USE BACK

If well telescopes please
sketch and show depths.

GROUND LEVEL

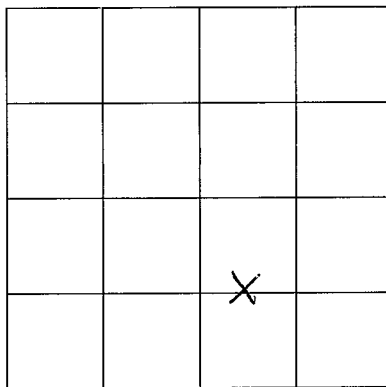

SECTION 1

Please indicate well location X.

ADDITIONAL INFORMATION

If more than one screen,
show location of each on sketch.