

MISSISSIPPI DEPARTMENT OF ENVIRONMENTAL QUALITY

Office of Land and Water Resources

P. O. Box 10631
Jackson, MS 39289-0631

WATER WELL DRILLERS LOG

COUNTY WELL LOCATED
Lincoln

WELL NUMBER 319513 CODED

G-2162

DATE WELL COMPLETED
7-18-00

PERMIT NUMBER
510

NAME OF DRILLING FIRM
Pasley Waterwell

B'haven MS 39601

NAME & MAILING ADDRESS OF LANDOWNER
Buck Nunnery

739 Denton Trl

Brookhaven MS 39601

WELL LOCATION: SEC _____ TOWNSHIP _____ RANGE _____
28 7 N 7 E

DISTANCE _____ MILES _____ of _____
DIRECTION _____ NEAREST TOWN _____

OTHER LANDMARK _____

WELL PURPOSE Home, Irrigation, Municipal, Industrial, Fish Pond, etc.

PUMP DATA

PUMP TYPE (Circle One):
 Submersible, Turbine, Jet, Flowing Well,
Other (Describe) _____

POWER TYPE (Circle One):
 Electric, Tractor, Diesel, Gasoline, Butane,
Other (Describe) _____ H/P _____

Pump Capacity (GPM) _____ No. of Stages _____ Setting Depth _____ FT.

PUMP TEST

Well yielded _____ GPM with
a drawdown of _____ ft.
after _____ hours of pumping

WELL DATA

Well Depth 180' Casing Diameter (In.) 4" Casing Length (Ft.) 160'

Type of Casing PVC Hole Depth _____ Depth to Static Water Level _____

LOG DATA

TYPE OF LOG RUN (Circle One): No Log Run, Electric, Gamma Ray, Density, Sonic, Neutron,
Other (Describe) _____

Name of Organization Running Log _____

TYPE OF COMPLETION: (Circle One or More):
 Gravel Packed, Underreamed, Telescoped,
 Natural Development, Open Hole, Other _____
(Describe) _____

WELL GROUTED TO A DEPTH OF 10 FEET
Type Grout (circle one): Cement, Bentonite, or Mix _____

GEOLOGIC DATA (Office Use Only)

Surface Elev.	Geologic Unit	Unit Thickness	Depth to Top
Subs. SWL	Date	Analysis	Aquifer Test

SCREEN DATA

Diameter - Inches 4" Length - Feet 20' Slot Size - Inches 0-12

Screen Type PVC Depth to Bottom - Feet _____

Driller's Remarks _____

Top of Lap Pipe or Reduction in Casing _____

FEET IF TELESCOPED OR MORE THAN ONE SCREEN: USE BACK PAGE


DESCRIPTION OF FORMATIONS ENCOUNTERED	FROM	TO
<u>Clay</u>	<u>0</u>	<u>20</u>
<u>Gravel</u>	<u>20</u>	<u>80</u>
<u>Clay</u>	<u>80</u>	<u>160</u>
<u>Gravel</u>	<u>160</u>	<u>180</u>

FORMATIONS (Continued)	FROM	TO

REC'D JUN 13 2001

If well telescopes please
sketch and show depths.

GROUND LEVEL

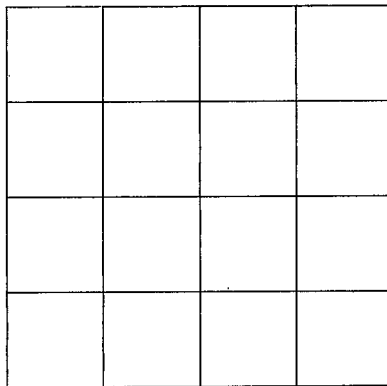

SECTION _____

Please indicate well location X.

ADDITIONAL INFORMATION

If more than one screen,
show location of each on sketch.