

Duplicate record?

MISSISSIPPI
BOARD OF WATER COMMISSIONERS
416 North State Street
Jackson, Mississippi 39201

CODED

WATER WELL DRILLERS LOG

Lincoln
~~5~~ H8
7-67
7-5-^{CODED}
1967

Layne Central Co. Lincoln
firm name county well located

date well completed

firm name

county well located

LANDOWNER: *City of Brookhaven, Miss.*
" "
(mailing address)
WELL LOCATION:
sec. 7 T. 7 N R. 8 E
3 blocks north of water plant
miles of (distance) (direction) (nearest town)

description of formations encountered	from	to
Clay	0	30
Sandy Clay	30	73
GRAVEL	73	97
Sandy Clay	97	130
COARSE SAND	130	175
Sandy Clay	175	274
Clay	274	325
Sandy Clay	325	358
FINE SAND	358	370
COARSE SAND	370	458

WELL PURPOSE: *MUNICIPAL*
(home, irrigation, municipal, industrial)

WELL COMPLETION DATA:

- (1) diameter (inches) 18"
- (2) total depth (feet) 450'
- (3) static water level (feet) 188' below top of ground.
- (4) casing Steel, 382' (material) (depth)

_____ if telescope see back.
(size)

- (5) screen 60', 382' (length) (depth to top)
12", Stainless Steel (size) (material)

- (6) pump 60 500 (HP) (yield gpm)
Electric (type power)


- (7) electric log no (yes or no)

_____ (organization running log)

- (8) how well bottom plugged _____

-80 on other log.

CODED

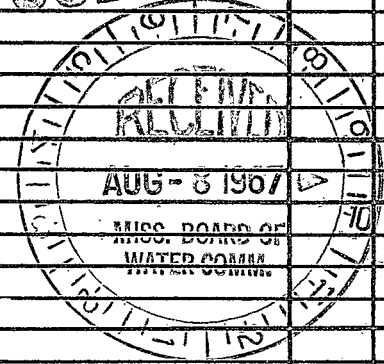


DRILLERS REMARKS:

Pump not installed as of this date - no test run -

If well telescopes please sketch and show depths.

GROUND LEVEL

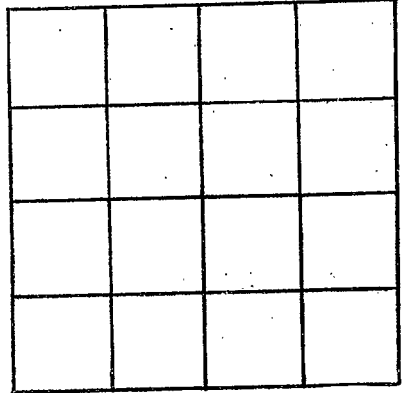

SECTION _____

Please indicate well location X.

ADDITIONAL INFORMATION

If more than one screen,
show locations of each on sketch.