

1001A
H8
7-67

MISSISSIPPI
BOARD OF WATER COMMISSIONERS
416 North State Street
Jackson, Mississippi 39201

WATER WELL DRILLERS LOG

7-5 1967 Leavelle Central Co. Lincoln
date well completed firm name county well located

LANDOWNER:
CITY OF BROOKHAVEN
BROOKHAVEN, MISS.
(mailing address)

description of formations encountered	from	to
Clay	0	30
Sandy Clay	30	73
GRAVEL	73	97
Sandy Clay	97	130
COARSE SAND	130	175
Sandy Clay	175	274
Clay	274	325
Sandy Clay	325	358
FINE SAND	358	370
COARSE SAND	370	458
Clay	458	


WELL LOCATION: NEAR R.R. TRACK
sec. 7 T. 7 N. R. 8 E.
S W
miles at of Brookhaven
(distance) (direction) (nearest town)

WELL PURPOSE: Municipal
(home, irrigation, municipal, industrial)

WELL COMPLETION DATA:

- (1) diameter (inches) 18"
- (2) total depth (feet) 462
- (3) static water level (feet) 188' below above top of ground.
- (4) casing Steel, 382' (material) (depth).
18" (size) if telescope see back.
- (5) screen 80', 382' (length) (depth to top)
12", Stainless Steel (size) (material)
- (6) pump 60 500 (HP) (yield gpm)
Electric (type power)
- (7) electric log NO (yes or no)
(organization running log)
- (8) how well bottom plugged VALVE

CODED

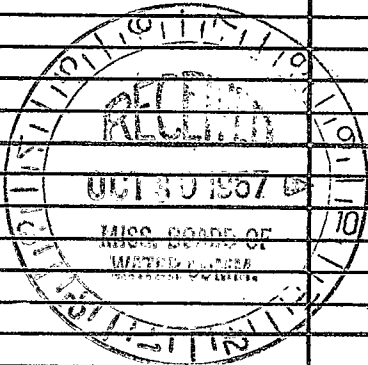


DRILLERS REMARKS:

50

If well telescopes please sketch and show depths.

GROUND LEVEL

SE NE SW

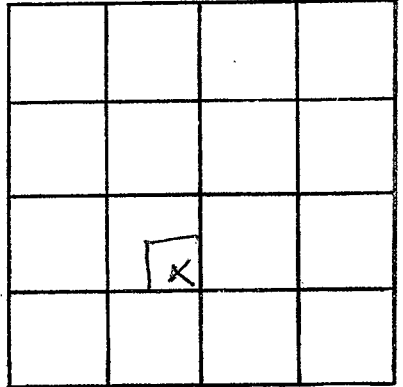

SECTION 7

Please indicate well location X.

ADDITIONAL INFORMATION

If more than one screen, show locations of each on sketch.