

~~before~~

H15

9-5-63 CODED

WATER WELL DRILLERS LOG

CODED

Date: 9-5-, 1963, Driller: Layne-Central Co. County Lincoln

(Name)

(1) Owner of Land: City of Brookhaven
 (Name)
Brookhaven, Mississippi
 (Address)

(2) Location: 1/4, 1/4, Sec. 7 T 7 R 8,
 miles of ,
 (distance) (direction) (Nearest Town)

(3) Topography:
 (Hilly) (Flat) (Level)

(4) Purpose of Well: Municipal
 (Domestic Irrigation
 Municipal, Industrial, Other)

Description & Color of Materials Sand, Clay, Red Clay, Shell, etc.	Thick- ness Feet	Depth Feet
soil	2	0
clay	42	44
sand-fine gravel and clay balls	36	80
sandy clay	44	124
sand-fine gravel and clay balls	38	162
clay stks of sand	10	172
clay stks of fine sand	88	260
clay	60	320
fine sand-stks clay	30	350
pk. sand (hard)	93	443
clay	20	463

Information upon completion of well:

(1) Diameter 18 inches.

(2) Total Depth 443 feet.

(3) Water Level 165' feet below top of ground.

(4) Cased to 371', Size 18"

(5) Screen: Size 10", Length 60'


(6) Were any formations sealed against pollution?
 x yes, no.

If YES depth of formation 371'

Why required

Drillers Remarks:

CODED

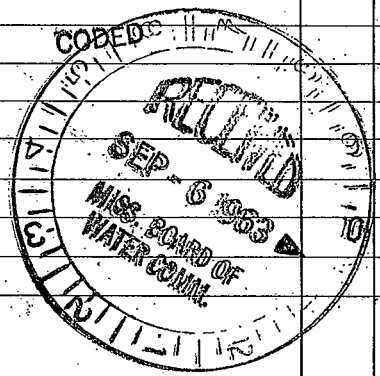

(Use Back Side)

Well No.

①