

H 16

CODED

WATER WELL DRILLERS LOG

H 300

10-10-60

Date: 10-10, 1960, Driller: Herring Sewersolt County Lincoln

Brookhaven Country Club

(Name)

(1) Owner of Land: City of Brookhaven

(Name)

Brookhaven, Miss.

(Address)

(2) Location: 1/4, 1/4, Sec. 6 T 7 R 8

1 miles North of Brookhaven (distance) (direction) (Nearest Town)

(3) Topography: (Hilly) (Flat) (Level)

(4) Purpose of Well: Swimming Pool (Domestic Irrigation Municipal, Industrial, Other)

Description & Color of Materials Sand, Clay, Red Clay, Shell, etc.

Thick-ness Feet

Depth Feet

Red Clay
Blue Clay
SAND
Clay
SAND

10'
90'
30'
215'
31'


10'
100'
130'
345'
376'

Information upon completion of well:

- (1) Diameter 8" inches.
(2) Total Depth 376' feet.
(3) Water Level 160' feet below top of ground.
(4) Cased to 366, Size 4"
(5) Screen: Size 4", Length 10'
(6) Were any formations sealed against pollution? yes, no.

CODED

If YES depth of formation
Why
Drillers Remarks:

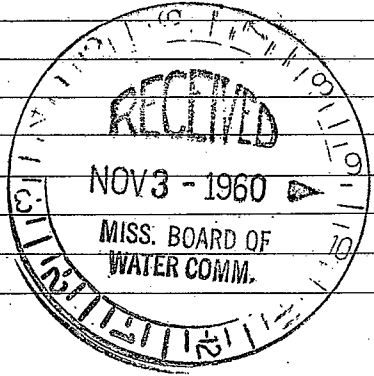

(Use Back Side)

Well No.

①