

LINCOLN

H28

CODED

4847?
7844

WATER WELL DRILLERS LOG

CODED

2-6-64

Date: 2/6/1964, Driller: Roy A. Chandler, County: Lincoln

(Name)


- (1) Owner of Land: Precher CUMMINGS
(Name)
3 Mi. SE ON RUTH ROAD
(Address) 29 78
- (2) Location: 1/4, 1/4, Sec. 29 78
3 miles SE, of B'HAVEN
(distance) (direction) (Nearest Town)
- (3) Topography: (Hilly) (Flat) (Level)
- (4) Purpose of Well: (Domestic) Irrigation
Municipal, Industrial, Other

Description & Color of Materials Sand, Clay, Red Clay, Shell, etc.	Thick- ness Feet	Depth Feet
top soil	2	2
yellow clay	10	10
Red clay & gravel	30	30
more gravel clay & sand	9 1/2	9 1/2
Water Sand	3 1/2	3 1/2
all water rocks as large as hens eggs to smaller sizes	6	6

Information upon completion of well:

- (1) Diameter 16" inches.
- (2) Total Depth 60' feet.
- (3) Water Level 52 1/2 feet below top of ground.
- (4) Cased to 60', Size 8" TILE.
- (5) Screen: Size NONE, Length —.
- (6) Were any formations sealed against pollution?

Well Cased
about 10 GAL PER MINUTE
CONTINUOUS BAILING
WATER PERFECTLY CLEAR IN ABOUT 10 minutes
Bailing - no screen & absolutely Sand free
Jet Pump put on well immediately
Plenty water for a home

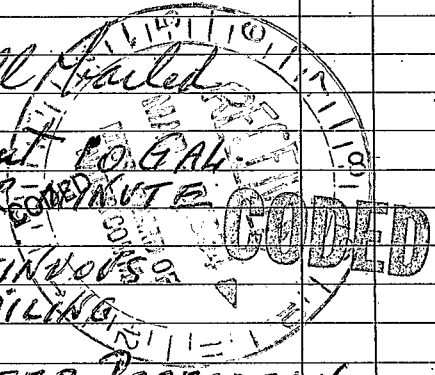

(yes) no.
Back filled with clay dirt from well.
Why: keep out rain water
Drillers Remarks: water

(Roy's Pump Shop)

Well No.

10