

**MISSISSIPPI
BOARD OF WATER COMMISSIONERS**
416 North State Street
Jackson, Mississippi 39201

WATER WELL-DRILLERS LOG

Lincoln
H29
7-66

CODED

7-19 1966 Lincoln
date well completed firm name county well located

LANDOWNER: Dr. J.R. Markette
Byrdchiffol 73 Miss
(mailing address)


WELL LOCATION:
sec 31 T 7 N ✓ R 8 E ✓
3 miles S of Brookhaven
(distance) (direction) (nearest town)

WELL PURPOSE:
(home, irrigation, municipal, industrial)

- WELL COMPLETION DATA:
- (1) diameter (inches) 4
 - (2) total depth (feet) 188
 - (3) static water level (feet) 50 below above top of ground.
 - (4) casing plastic, 180,
(material) (depth)
4 if telescope see back.
(size)
 - (5) screen 81, 180
(length) (depth to top)
4, plastic
(size) (material)
 - (6) pump 5 Turbine 65
(HP) (yield gpm)
Elec.
(type power)
 - (7) electric log NO
(yes or no)
(organization running log)
 - (8) how well bottom plugged Wood Peg

description of fomations encountered	from thick ness	to Depth
<u>top soil</u>	<u>0</u>	<u>20</u>
<u>Red sand</u>	<u>20</u>	<u>40</u>
<u>Sand & gravel</u>	<u>15</u>	<u>55</u>
<u>Chalk</u>	<u>65</u>	<u>120</u>
<u>lime sand</u>	<u>40</u>	<u>160</u>
<u>progressively coarser</u>	<u>30</u>	<u>190</u>


CODED

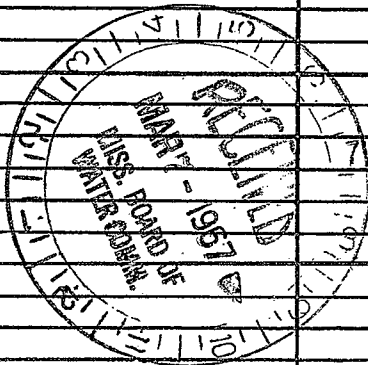

DRILLERS REMARKS:

If well telescopes please sketch and show depths.

GROUND LEVEL

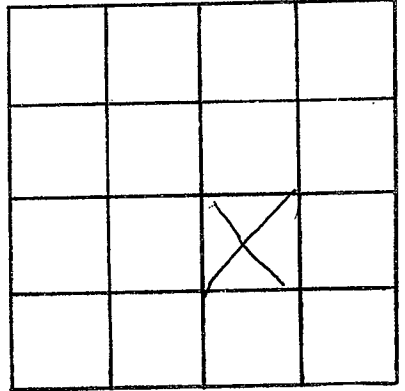

SECTION 81

Please indicate well location X.

ADDITIONAL INFORMATION

If more than one screen,
show locations of each on sketch.