

Lincoln **CODED**
 H31
 9-67

MISSISSIPPI
 BOARD OF WATER COMMISSIONERS
 416 North State Street
 Jackson, Mississippi 39201

WATER WELL DRILLERS LOG

9-28 1967 Fitzgerald Water Well Lincoln
 date well completed firm name county well located

LANDOWNER: Gene
Burkshaw R Mrs
 (mailing address)

WELL LOCATION:
 sec 36 T 7 N R 2 E
3 miles 5 of Burkshaw
 (distance) (direction) (nearest town)

WELL PURPOSE: house
 (home, irrigation, municipal, industrial)


- WELL COMPLETION DATA:
- (1) diameter (inches) 4
 - (2) total depth (feet) 106
 - (3) static water level (feet) 30 below top of ground.
 - (4) casing plastic 100
 (material) (depth)
4 if telescope see back.
 (size)
 - (5) screen 6' 100
 (length) (depth to top)
4 plastic
 (size) (material)
 - (6) pump 5 1/2 15
 (HP) (yield gpm)
elec
 (type power)
 - (7) electric log no
 (yes or no)

(organization running log)
 (8) how well bottom plugged wood peg

DRILLERS REMARKS:


description of formations encountered	from	to
top soil clay	0	14
gravel & chalk	14	22
sandy gravel	22	34
Rock	34	36
white chalk	36	48
fine sand	48	95
coarse sand	95	106
Rock	106	

CODED

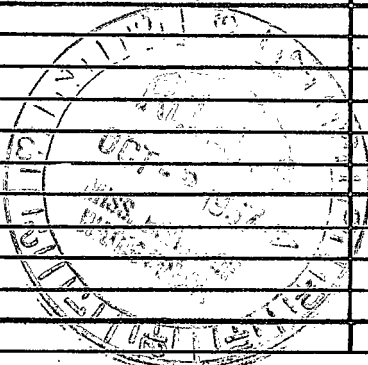

If well telescopes please sketch and show depths.

GROUND LEVEL

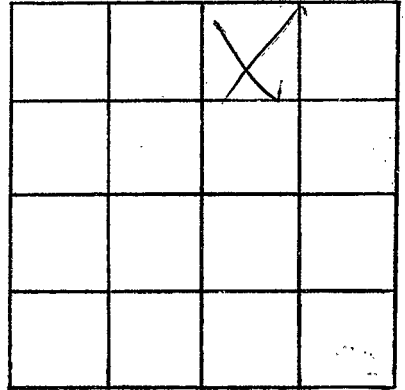

SECTION

3d

Please indicate well location X.

ADDITIONAL INFORMATION

If more than one screen,
show locations of each on sketch.