

Lincoln
H32
10-67

MISSISSIPPI
BOARD OF WATER COMMISSIONERS
416 North State Street
Jackson, Mississippi 39201

WATER WELL DRILLERS LOG

08/12/67 date well completed
67 Levee well Drillers firm name
Lincoln county well located

LANDOWNER: Ed. White
Rt 4
Brookhaven, Miss
(mailing address)

description of formations encountered	from	to
Red Clay	0	15
Red Sandy clay	15	50
Clayey gravel	50	75
Red gravel & sand	75	88


WELL LOCATION:
sec 35 T 7 N R 8 E
5 miles SE Brookhaven
(distance) (direction) (nearest town)

WELL PURPOSE: Home
(home, irrigation, municipal, industrial)

WELL COMPLETION DATA:


- (1) diameter (inches) 4"
- (2) total depth (feet) 88
- (3) static water level (feet) 43 below top of ground
- (4) casing Plastic bottom
(material) (depth)
- if telescope see back.
(size)
- (5) screen 6' 82'
(length) (depth to top)
- 4" Plastic
(size) (material)
- (6) pump 1/2 HP
(type power) (yield gpm)
- (7) electric log no
(yes or no)
- (organization running log)

(8) how well bottom rugged
wooden plug
DRILLERS REMARKS: old well bore

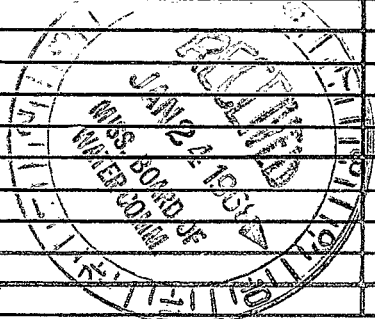

If well telescopes please
sketch and show depths.

GROUND LEVEL

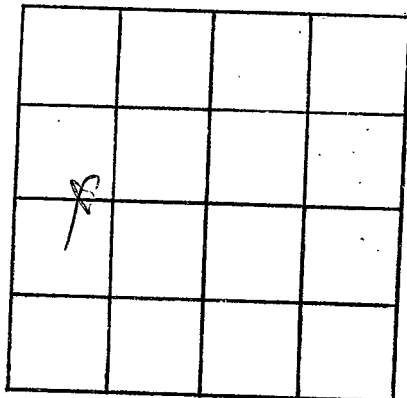

SECTION 30

Please indicate well location X.

ADDITIONAL INFORMATION

If more than one screen,
show locations of each on sketch.