

Lincoln  
 H 33  
 5-68

MISSISSIPPI  
 BOARD OF WATER COMMISSIONERS  
 416 North State Street  
 Jackson, Mississippi 39201

WATER WELL DRILLERS LOG

5-20 1968 Fitzgibbon well Sew Lincoln  
 date well completed firm name county well located

LANDOWNER: Larry Duff

description of formations encountered	from	to
---------------------------------------	------	----

P.R. Blackburn Miss.  
 (mailing address)

<u>Red clay</u>	<u>0</u>	<u>15</u>
<u>Red sand</u>	<u>15</u>	<u>25</u>
<u>Blue chalk</u>	<u>25</u>	<u>90</u>
<u>Coarse sand</u>	<u>90</u>	<u>100</u>

WELL LOCATION:  
 sec. 2 T 7 N R 8 E  
2 miles W of Huecks  
 (distance) (direction) (nearest town)

WELL PURPOSE:  
 (home, irrigation, municipal, industrial)

WELL COMPLETION DATA:

- (1) diameter (inches) 4
- (2) total depth (feet) 100
- (3) static water level (feet) 60 below/above top of ground.
- (4) casing Plastic 9ft,  
 (material) (depth)  
4 if telescope see back.  
 (size)
- (5) screen 6, 94  
 (length) (depth to top)  
4, plastic  
 (size) (material)
- (6) pump 7, 7  
 (HP) (yield gpm)  
ele  
 (type power)
- (7) electric log no  
 (yes or no)  
 (organization running log)
- (8) how well bottom plugged Wood peg


RODDED

FORM-6-13-60  
 MISS. BOARD OF  
 WATER COMMISSIONERS

DRILLERS REMARKS:

If well telescopes please sketch and show depths.

GROUND LEVEL

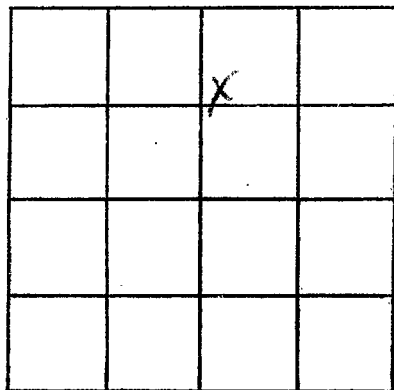

SECTION 2

Please indicate well location X.

ADDITIONAL INFORMATION

If more than one screen, show locations of each on sketch.