

LINCOLN MISSISSIPPI BOARD OF WATER COMMISSIONERS

H36

OR GER
10/17/68

8-21-64 CODED

WATER WELL DRILLERS LOG

Date: 8/21/64, 1964, Driller: Roy, Chandrupa County: Lincoln
(Name)

(1) Owner of Land: M.E. Flynn
(Name) PPS LBR.
Phillips Rhyme Co
(Address)

(2) Location: 1/4, 1/4, Sec. 9 T7R8
2 miles N.E. of BROOKHAVEN
(distance) (direction) (Nearest Town)

(3) Topography: med
(Hilly) (Flat) (Level)

(4) Purpose of Well: Domestic
(Domestic Irrigation, Municipal, Industrial, Other)

Description & Color of Materials Sand, Clay, Red Clay, Shell, etc.	Thick- ness Feet	Depth Feet
<u>well cut clay</u>	<u>3</u>	<u>3</u>
<u>white chalk</u>		
<u>white sand</u>	<u>50</u>	<u>50</u>
<u>yellow coarse sand</u>	<u>10</u>	<u>10</u>
<u>coarse white sand & some gravel</u>	<u>12</u>	<u>12</u>

Information upon completion of well:

(1) Diameter 14 inches.

(2) Total Depth 75 feet.

(3) Water Level 59 feet below top of ground.

(4) Cased to 7.5', Size 8" tile.


(5) Screen: Size NONE, Length NONE.

(6) Were any formations sealed against pollution?
_____ yes, _____ no.

Furnishing
500 Gals. hour.
CODED
PPS
on electric
jet pump

If YES depth of formation 10' Cement
Why around tile
FHA SPECIFICATION
Drillers Remarks:

Corrected

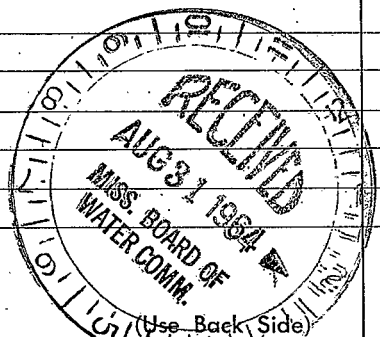

Well No.

