

CODED

Lincoln
H37
8-68

MISSISSIPPI
BOARD OF WATER COMMISSIONERS
416 North State Street
Jackson, Mississippi 39201

WATER WELL DRILLERS LOG

8-25-68 *Approved* *Water Well Driller*
date well completed firm name county well located


LANDOWNER: *Shipp*
Brookhaven Pt MS's
(mailing address)

WELL LOCATION:
sec *21* T *2* N *8* E
S *5* W
miles *5* of *Brookhaven*
(distance) (direction) (nearest town)

WELL PURPOSE: *home*
(home, irrigation, municipal, industrial)

- WELL COMPLETION DATA:
- (1) diameter (inches) *4*
 - (2) total depth (feet) *196*
 - (3) static water level (feet) *85* below above top of ground.
 - (4) casing *plastic 100*
(material) (depth)
4 if telescope see back.
(size)
 - (5) screen *6'* *196*
(length) (depth to top)
6 *5ch 40*
(size) (material)
 - (6) pump *Spec*
(HP) (yield gpm)
(type power)
 - (7) electric log *no*
(yes or no)
(organization running log)
 - (8) how well bottom plugged *plugged*


description of formations encountered	from	to
<i>top 32' clay</i>	<i>0'</i>	<i>32'</i>
<i>sand</i>	<i>32'</i>	<i>80'</i>
<i>granite sand</i>	<i>80'</i>	<i>87'</i>
<i>Chalk</i>	<i>87'</i>	<i>145'</i>
<i>fine to medium sand</i>	<i>145'</i>	<i>190'</i>
<i>coarse sand</i>	<i>190'</i>	<i>200'</i>

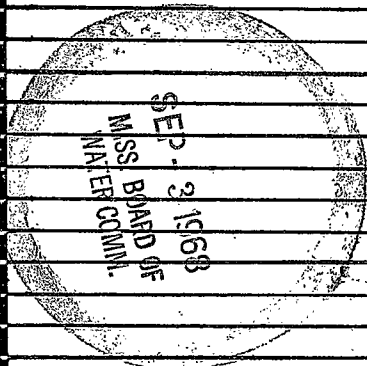

DRILLERS REMARKS:

If well telescopes please sketch and show depths.

GROUND LEVEL

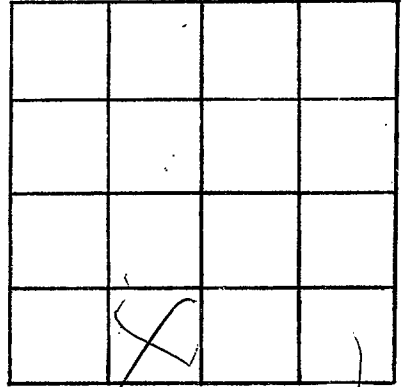

SECTION 28

Please indicate well location X.

ADDITIONAL INFORMATION

If more than one screen,
show locations of each on sketch.