

618 A. E. Chewke?

Lincoln
H 39
11-26-68

MISSISSIPPI
BOARD OF WATER COMMISSIONERS
416 North State Street
Jackson, Mississippi 39201

CODED

WATER WELL DRILLERS LOG

Nov. 26 1968 J.T. Conington Lincoln
date well completed firm name county well located

LANDOWNER: James Puckering

description of formations encountered from to

Brookhaven
(mailing address)

2/104
Sand 0 10
10 57

WELL LOCATION:

sec. 17 T. 7 N R. 8 E
S W
1/2 miles East of Brookhaven
(distance) (direction) (nearest town)

WELL PURPOSE: Home
(home, irrigation, municipal, industrial)

WELL COMPLETION DATA:

- (1) diameter (inches) 4"
- (2) total depth (feet) 57'
- (3) static water level (feet) 20' below top of ground.
- (4) casing Plastic, 51' (material) (depth)
(size) If telescope see back.
- (5) screen 6' 57' (length) (depth to top)
4" Plastic (size) (material)
- (6) pump 1/2 5 (HP) (yield gpm)
A-2 (type power)
- (7) electric log (yes or no)

CODED

(organization running log)


(8) how well bottom plugged none

DRILLERS REMARKS:

MISS. BD. OF WATER COMMISSIONERS
33 1000

If well telescopes please sketch and show depths.

GROUND LEVEL

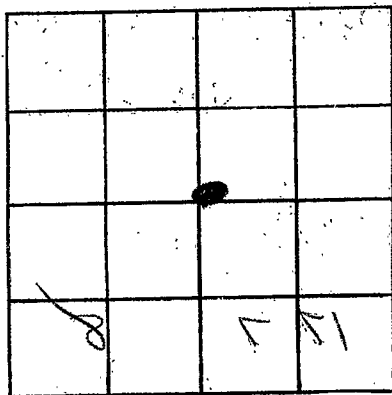

SECTION 17

Please indicate well location X.

ADDITIONAL INFORMATION

If more than one screen,
show locations of each on sketch.