

old Wesson Rd

MISSISSIPPI
BOARD OF WATER COMMISSIONERS
416 North State Street
Jackson, Mississippi 39201

CODED

WATER WELL DRILLERS LOG

Lincoln
H 40
6-69

6-9 1969 *Desirey Const Co* Lincoln
date well completed firm name county well located

LANDOWNER:

Desirey Const. Co.
Brookhaven, Miss.
(mailing address)

description of formations encountered

from to

Red clay 0 15
Red sand 15 35
Blue clay 35 120
Course sand 120 160

WELL LOCATION:

sec. 8 T. 7 N R. 8 E
1 miles NE of Brookhaven
(distance) (direction) (nearest town)

WELL PURPOSE:

Home
(home, irrigation, municipal, industrial)

WELL COMPLETION DATA:


- (1) diameter (inches) 4
- (2) total depth (feet) 160
- (3) static water level (feet) 30 below above top of ground.
- (4) casing Plastic 154
(material) (depth)
4 if telescope see back.
(size)
- (5) screen 6 154
(length) (depth to top)
4 Plastic
(size) (material)
- (6) pump 1/2 10
(HP) (yield gpm)
Electric
(type power)
- (7) electric log no
(yes or no)
(organization running log)
- (8) how well bottom plugged seal

DRILLERS REMARKS:

MISS. BD. OF
WATER COMMISSIONERS

If well telescopes please sketch and show depths.

GROUND LEVEL

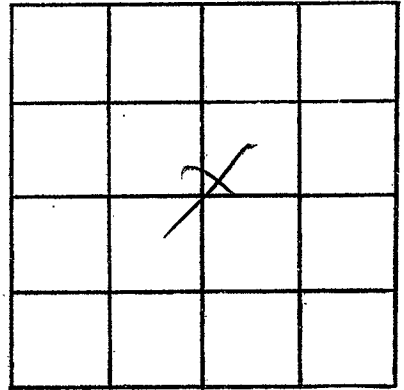

SECTION 8

Please indicate well location X.

ADDITIONAL INFORMATION

If more than one screen,
show locations of each on sketch.