

CODED

MISSISSIPPI  
BOARD OF WATER COMMISSIONERS  
416 North State Street  
Jackson, Mississippi 39201

WATER WELL DRILLERS LOG

Lincoln  
H41  
9-12-69  
M-G-S

date well completed

firm name

county well located

LANDOWNER: Lincoln  
Rural Water Assoc.  
Brookhaven, Miss.  
(mailing address)

description of formations encountered

from to

WELL LOCATION:  
sec. 6 T. 7 N. R. 8 E  
app. 2 miles N of Brookhaven  
(distance) (direction) (nearest town)

yellow clay 0 22  
sand + pea gravel 22 85

WELL PURPOSE: Domestic  
(home, irrigation, municipal, industrial)

Large Gravel 85 110

WELL COMPLETION DATA:

sand + pea gravel 110 162

(1) diameter (inches) 12"  
(2) total depth (feet) 419'  
(3) static water level (feet) 188' below top of ground.

Clay 162 174

(4) casing steel, 360',  
(material) (depth)  
12" and 62' x 8"  
(size) if telescope see back.

sand, silt, clay 174 205

(5) screen 40', 372'  
(length) (depth to top)  
8" stainless steel  
(size) (material)

Clay 205 362

(6) pump \_\_\_\_\_ (HP) \_\_\_\_\_ (yield gpm)  
Electric  
(type power)

sand 362 419

(7) electric log yes  
(yes or no)  
Miss. Geo. Survey  
(organization running log)

Clay 419 512

(8) how well bottom plugged Valve

SEP 18 1969


DRILLERS REMARKS:

MISS. DEPT. OF WATER CONTROL

Pump not installed as of this date.

If well telescopes please sketch and show depths.

GROUND LEVEL

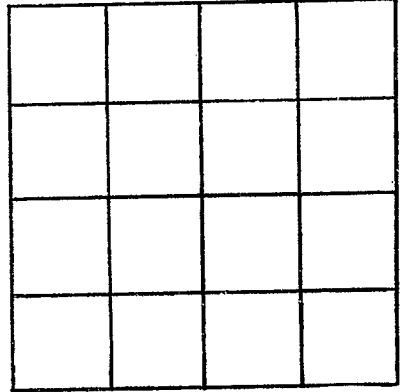

SECTION 6

Please indicate well location X.

ADDITIONAL INFORMATION

If more than one screen,  
show locations of each on sketch.