

MISSISSIPPI
 BOARD OF WATER COMMISSIONERS CODED
 416 North State Street
 Jackson, Mississippi 39201

WATER WELL DRILLERS LOG

July 16 69 James Well Drilling Lincoln
 date well completed firm name county well located

LANDOWNER: MAK Co
Brookhaven
 (mailing address)

WELL LOCATION:
 sec 22 T 7 N R 4 E
3 miles ESE of Brookhaven
 (distance) (direction) (nearest town)

WELL PURPOSE: Industrial
 (home, irrigation, municipal, industrial)

WELL COMPLETION DATA:

- (1) diameter (inches) 4
- (2) total depth (feet) 90
- (3) static water level (feet) 49 below above top of ground.
- (4) casing Plastic Ballou
 (material) (depth)
- (size) If telescope see back.
- (5) screen 10 89
 (length) (depth to top)
- 4" Plastic
 (size) (material)
- (6) pump 3/4 sub 15
 (HP) (yield-gpm)
- Sub
 (type power)
- (7) electric log NO
 (yes-or-no)

(organization-running-log)

(8) how well bottom plugged
wood chips


DRILLERS REMARKS:
New location

description of formations encountered	from	to
Red clay	0	14
Red sand	14	75
Coarse sand	75	83
Small gravel	83	90

SFD
 MISS. DEPT. OF WATER CONTROL

If well telescopes please sketch and show depths.

GROUND LEVEL

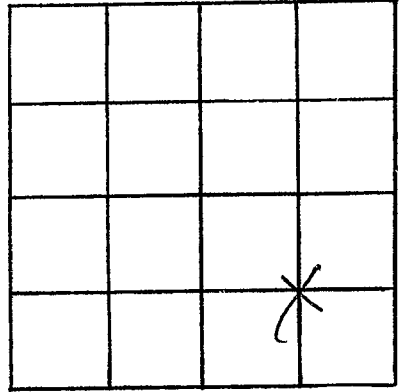

SECTION ZZ

Please indicate well location X.

ADDITIONAL INFORMATION

If more than one screen,
show locations of each on sketch.