

W.L. Behan Rd.

MISSISSIPPI
BOARD OF WATER COMMISSIONERS
416 North State Street
Jackson, Mississippi 39201

CODED

WATER WELL DRILLERS LOG

LINCOLN
H45
8-4-70

8-4
date well completed

1970 To Fitzgerald Well Co.
firm name

Lincoln
county well located

LANDOWNER:
Columbus Lbr Co.
P.O. Box Brookhaven Miss.
(mailing address)
WELL LOCATION:
sec. 7 T 9N R 8E
14 miles Brookhaven
(distance) (direction) (nearest town)

description of formations encountered	from	to
Red clay	0	20
Red sand	20	70
Coarse sand	70	95
Fine sand	95	155
Coarse sand	155	166

WELL PURPOSE: Industrial
(home, irrigation, municipal, industrial)

WELL COMPLETION DATA:
(1) diameter (inches) 4
(2) total depth (feet) 166
(3) static water level (feet) 70 below above top of ground.
(4) casing Aluminum 150
(material) (depth)
4 if telescope see back.
(size)
(5) screen 16 150
(length) (depth to top)
4 Aluminum
(size) (material)
(6) pump 2 40
(HP) (yield gpm)
elc
(type power)
(7) electric log no
(yes or no)
(organization running log)
(8) how well bottom plugged good

CODED


AUG 17 1970

DRILLERS REMARKS:

MISS. Bd. OF
WATER COMMISSIONERS

If well telescopes please sketch and show depths.

GROUND LEVEL

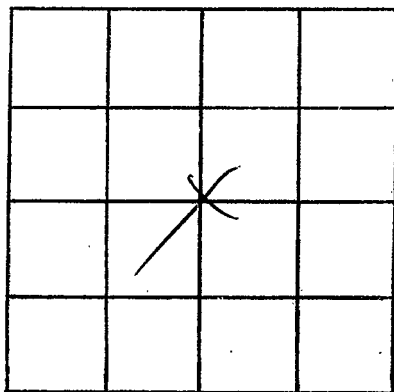

SECTION 7

Please indicate well location X.

ADDITIONAL INFORMATION

If more than one screen, show locations of each on sketch.